

MAR 24 2000

SECTION

LAND CORNER RECORDATION CERTIFICATE
Filing Requirement of Act 74, Mich. P.A. 1970
Clare County Remonumentation

For Corners in

Clare (County)	Located In:	Corner Code#:
1. Public Land Survey	T. <u>17N</u> R. <u>5W</u>	<u>1-5</u>
	T. _____ R. _____	_____
	T. _____ R. _____	_____
2. Public Controlling in Section	S. _____ T. _____ R. _____	_____
	S. _____ T. _____ R. _____	_____
3. Miscellaneous Property in Section	S. _____ T. _____ R. _____	_____
	S. _____ T. _____ R. _____	_____
4. Lot No. _____, Recorded Plat _____		
5. Private Claims _____		

199900009787
Filed for Record in
CLARE COUNTY MICHIGAN
CAROL MCAULAY
On 11-10-1999 At 01:30 pm.
LAND CORNER 9.00
OR Liber 2 Page 66 - 66

Instrument 199900009787 OR Liber 2 Page 66

377-99

Register of Deeds Stamp & File Number

I, Mark R. Robison, in a field survey on July 7, 1999, do hereby certify that under requirements of P.A. 74, Michigan P.A. of 1970, the corner points mentioned in lines 1 and 2 above were in conformance with regulations and rules therefore as required in the current manual of survey instructions of the United States Department of the Interior, Bureau of Land Management or by a decree of a Court of Law and/or that the corner points mentioned in lines 3, 4 and 5 above were in conformance with the rules of the Michigan Board of Land Surveyors or by a Decree of a Court of Law, established, re-established, monumented, re-monumented, recovered, found as expressed below.

	A	B	C	D	E	F	G	H	I	J	K	L	M
1													
2	6	5	4	3	2	1							
3													
4	7	8	9	10	11	12							
5													
6	18	17	16	15	14	13							
7													
8	19	20	21	22	23	24							
9													
10	30	29	28	27	26	25							
11													
12	31	32	33	34	35	36							
13													

NOTE: Not more than 2 corners, all in the same town and range, may be recorded on this certificate.

A. Description of original monument and accessories and/or subsequent restoration:

1837 Nicholson
Set Post Cor. Sec. 10, 11, 14, 15
Pine - 22" S26E 16
Hemlock 13" S74W 15

1916 Unknown, CSR 6, Pg. 10, 11, 14, 15
Pine 16" S27E 16
Pine 16" N58 1/2 E 59

1970 MSHD, Project #18024
Fd 3/4" bolt w/square head 1.0' below
surface in line with E & W fence and
1.0' W of Ctr. of N-S Road.
N60°W 57.99 3" R. Pine
N88°E 32.39 R.R. Tie F. Post
N55°E 63.24 P. Pole


1977 Fluharty, (132) 2-273 & LCRC #296
Fd 1 1/4" sq hd. bolt at C.L. Road
N57°W 57.88 8" Red Pine
S89°E 32.42 Sq. Fe. Post
N57°E 63.28 P.P.

B. Description of corner evidence found and/or method applied in restoring or re-establishing corner:
See dossier for detailed report.

Found 1 1/2" square head bolt in 3" tile. Fd two 1970/1977 witnesses. Excavated bolt & replaced with 5/8" x 36" re-rod and cap.

C. Description of monument for corner and accessories established to perpetuate locating the position of the corner
Set 5/8" x 36" re-rod with Clare Co. Remon Cap marked P.S. #27458 in tile in gravel road. Accepted as best available evidence of the perpetuation of the C.S.R. Corner.

Witnesses:
N58°E 65.70 Set spike in new P.P.
S38°W 58.19 Fd spike in 6" Locust Tree
N82°W 29.42 Set spike in P.P.
N57°W 57.83 Set spike in 15" R. Pine (OBT)

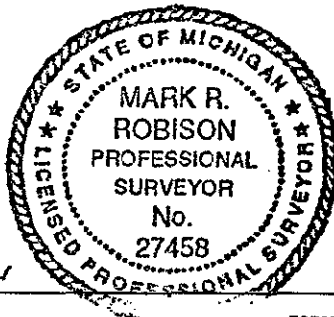

APPROVED LAND CORNER
P.A. 345 of 1990
Clare County

Chairman Paul D. Sopher
Date 9-29-99

Signed by Mark R. Robison
Surveyor's Michigan License No. 27458

Date 11-8-99