

MAR 24 2000

SECTION

LAND CORNER RECORDATION CERTIFICATE
Filing Requirement of Act 74, Mich. P.A. 1970
Clare County Remonumentation

For Corners in
Clare
(County) Located In: Corner Code#:
1. Public Land Survey T. 17N R. 5W I-6
2. Public Controlling S. T. R.
in Section S. T. R.
3. Miscellaneous S. T. R.
Property in Section S. T. R.
4. Lot No. , Recorded Plat
5. Private Claims

199900009791
Filed for Record in
CLARE COUNTY MICHIGAN
CAROL MCAULAY
On 11-10-1999 At 01:30 pm.
LAND CORNER 9.00
OR Liber 2 Page 70 - 70

Instrument 199900009791 OR Liber 2 Page 70

#381-99

Register of Deeds Stamp & File Number

I, Mark R. Robison, in a field survey on July 7, 1999, do hereby certify that under requirements of P.A. 74, Michigan P.A. of 1970, the corner points mentioned in lines 1 and 2 above were in conformance with regulations and rules therefore as required in the current manual of survey instructions of the United States Department of the Interior, Bureau of Land Management or by a decree of a Court of Law and/or that the corner points mentioned in lines 3, 4 and 5 above were in conformance with the rules of the Michigan Board of Land Surveyors or by a Decree of a Court of Law, established, re-established, monumented, re-monumented, recovered, found as expressed below.

Grid table with columns A-M and rows 1-13. Contains numbers 1-36 in a grid pattern.

NOTE: Not more than 2 corners, all in the same town and range, may be recorded on this certificate.

A. Description of original monument and accessories and/or subsequent restoration:

1837 Nicholson
40.00 Hemlock 10" qr. Sec. Post

Circa 1900 Unknown, C.S.R. 6-14 & 6-15
Pine 16" N81E 47
Pine 16" S63W 47

1977 Fluharty, (132) 2-273 & LCRC #296
Fd 3/4" pipe at C.L. Road & off
fence to East.
S42W 55.53 24" Oak
S83W 32.64 32" Oak
N50W 38.75 T.P.

1970 M.S.H.D, Project 18024
Fd 1/2" Pipe & 3" tile 1 1/2' below
Rd. Surface. Raised w/ 3/4" x 1' pipe
in line w/fence W. 3' E of C.L.
N-S Road.
S85E 32.08 Cor. F. Post
S40W 54.96 19" Oak
S85W 32.40 23" Oak


1980 Lapham, LCRC #384
Fd 3/4" Pipe
East 32.2 Cor. Post
N45W 38.75 T.P.
S40W 55.50 24" Oak
S45E 54.33 square fence post

B. Description of corner evidence found and/or method applied in restoring or re-establishing corner:
See dossier for detailed report.

Fd 3/4" x 12" pipe over 3" tile and 3" x 2" top iron at 18" depth. Fd all 1970 & 1977 witnesses and three 1980 witnesses.

C. Description of monument for corner and accessories established to perpetuate locating the position of the corner
Set 5/8" x 36" re-rod with Clare Co. Remon Cap marked P.S. #27458 in tile in C.L. road. Accepted as best available evidence of the perpetuation of the C.S.R. Corner.

Witnesses:
S40°E 74.87 Set spike in 6" Oak
S36°W 55.48 Set spike in 24" Oak (OBT)
S85°W 32.21 Set spike in 36" Oak (OBT)
N50°W 38.81 Set spike in Tel. Pole (OBT)

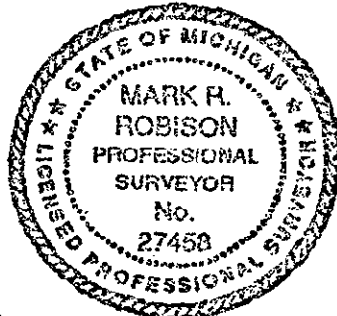

APPROVED LAND CORNER
P.A. 345 of 1990
Clare County

Chairman [Signature]
Date 9-29-99

Signed by [Signature]
Surveyor's Michigan License No. 27458

Date 11-8-99