

MAR 24 2000

SECTION

LAND CORNER RECORDATION CERTIFICATE  
Filing Requirement of Act 74, Mich. P.A. 1970  
Clare County Remonumentation

For Corners in  
Clare

(County)

Located In:

Corner Code#:

1. Public Land Survey T. 17N R. 5W I-7  
T. \_\_\_\_\_ R. \_\_\_\_\_  
T. \_\_\_\_\_ R. \_\_\_\_\_
2. Public Controlling S. \_\_\_\_\_ T. \_\_\_\_\_ R. \_\_\_\_\_  
in Section S. \_\_\_\_\_ T. \_\_\_\_\_ R. \_\_\_\_\_
3. Miscellaneous S. \_\_\_\_\_ T. \_\_\_\_\_ R. \_\_\_\_\_  
Property in Section S. \_\_\_\_\_ T. \_\_\_\_\_ R. \_\_\_\_\_
4. Lot No. \_\_\_\_\_, Recorded Plat \_\_\_\_\_
5. Private Claims \_\_\_\_\_

199900009792  
Filed for Record in  
CLARE COUNTY MICHIGAN  
CAROL MCAULAY  
On 11-10-1999 At 01:30 pm.  
LAND CORNER 9.00  
OR Liber 2 Page 71 - 71

Instrument Liber Page  
199900009792 OR 2 71

#382-99

Register of Deeds Stamp & File Number

I, Mark R. Robison, in a field survey on 7-7-99, do hereby certify that under requirements of P.A. 74, Michigan P.A. of 1970, the corner points mentioned in lines 1 and 2 above were in conformance with regulations and rules therefore as required in the current manual of survey instructions of the United States Department of the Interior, Bureau of Land Management or by a decree of a Court of Law and/or that the corner points mentioned in lines 3, 4 and 5 above were in conformance with the rules of the Michigan Board of Land Surveyors or by a Decree of a Court of Law, established, re-established, monumented, re-monumented, recovered, found as expressed below.

NOTE: Not more than 2 corners, all in the same town and range, may be recorded on this certificate.

	A	B	C	D	E	F	G	H	I	J	K	L	M
1													
2	6	5	4	3	2	1							
3													
4	7	8	9	10	11	12							
5													
6	18	17	16	15	14	13							
7													
8	19	20	21	22	23	24							
9													
10	30	29	28	27	26	25							
11													
12	31	32	33	34	35	36							
13													

A. Description of original monument and accessories and/or subsequent restoration:

1837 Hodson, Cor. Sec. 14, 15, 22, 23  
Hemlock 6 S54E 09  
Hemlock 6 S1W 17

9-14-73 Urbaniak, (132) 1-568  
References LCRC #5  
Meas. East 2620.82 to J-7

Circa 1900, CSR 6-14 & 15  
B. Oak 7 S71 1/2 E66  
Tele Pole 10 N57W 66

5-1-72 Lapham LCRC #29  
Mon. Box at int. C.L. Surrey & Finley  
Lake Ave.

5-27-81 Lapham, (132) 2-650  
Fd. Mon Box

Circa 1965 M.S.H.D. US10 R/W Plan 18024  
Fd 3/8" Ir. Rod 10.8 to S.E.M. & 9.4' to  
N.E.M. & 4.6' W of line fence South  
N50°W 71.18 P. Pole  
N20°W 67.67 T. Pole  
N45°E 44.66 Cor. Fe. Post

5-8-72 Lapham, (132) 1-103  
Same as LCRC #29  
Meas. East 2621.12 to J-7

4-20-83 Lapham LCRC #431  
Fd. Mon. Box  
N60°E, 55.0 P.P.  
N70°W 20.3 Gas Line Marker  
N05°E 139.4 Bridge Head wall

1968 Meyers, L.9-6  
Circle E Subdivision

10-24-73 Lapham, (132) 1-565  
References LCRC #57  
Meas. East 2621.12 to J-7

8-16-83 Urbaniak, (132) 2-791  
Same as (132) 2-556  
Meas. East 2621.12 to J-7

4-12-72 Urbaniak, (132) 1-249  
S65W 53.74 Face Proj. Marker  
S63E 75.52 P.P.  
N57E 76.76 P.P.  
Meas. West 2644.78 to H-7

7-10-74 Lapham, (132) 1-745  
References LCRC #57

7-22-91 Robison  
Ref. S.W. Cor. Sec 14 - No Wit  
Meas. East 2621.13 To J-7

4-29-80 Lapham, (132) 2-556  
Fd. Mon. Box  
Witnesses same as (132) 1-249


10-2-72 Lapham LCRC #57  
Same as (132) 1-249

B. Description of corner evidence found and/or method applied in restoring or re-establishing corner:  
See dossier for detailed report.

Found 3/4" x 10" square head bolt in Mon. Box. Found two 1965 MSHD witnesses. Fence to South is 4.6' East.

C. Description of monument for corner and accessories established to perpetuate locating the position of the corner:  
Set 5/8" x 36" rod with Clare Co. Remon Cap marked P.S. #27458 in Mon. Box. Accepted as best available evidence of the accepted position of the corner.

Witnesses:  
N60°E 61.00 N & T in new P.P.  
N50°W 71.68 N & T in P.P. (OBT)  
N20°W 67.67 N & T in P.P. (OBT)  
S57°W 68.54 N & T in P.P.

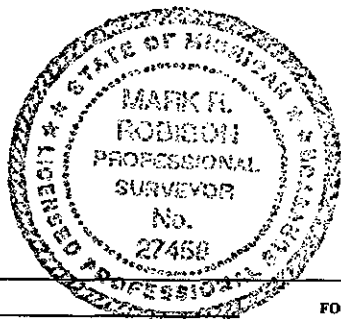

APPROVED LAND CORNER  
P.A. 345 of 1990  
Clare County

Chairman Paul Lapham  
Date 9-29-99

Signed by Mark R. Robison  
Surveyor's Michigan License No. 27458

Date 11-8-99