

**SURVEY & REMONUMENTATION**

**MAR 24 2000**

**LAND CORNER RECORDATION CERTIFICATE**  
**Filing Requirement of Act 74, Mich. P.A. 1970**  
**Clare County Remonumentation**

**SECTION**

For Corners in  
Clare  
 (County)

	Located In:	Corner Code#:
1. Public Land Survey	T. <u>17N</u> R. <u>5W</u>	<u>J-7</u>
	T. _____ R. _____	_____
	T. _____ R. _____	_____
2. Public Controlling in Section	S. _____ T. _____ R. _____	_____
	S. _____ T. _____ R. _____	_____
3. Miscellaneous Property in Section	S. _____ T. _____ R. _____	_____
	S. _____ T. _____ R. _____	_____
4. Lot No. _____, Recorded Plat _____		
5. Private Claims _____		

199900009780  
 Filed for Record in  
 CLARE COUNTY MICHIGAN  
 CAROL MCAULAY  
 On 11-10-1999 At 01:30 pm.  
 LAND CORNER 9.00  
 OR Liber 2 Page 59 - 59

Instrument Liber Page  
 199900009780 OR 2 59

# 370-99

Register of Deeds Stamp & File Number

I, Mark R. Robison, in a field survey on 9-22-99 do hereby certify that under requirements of P.A. 74, Michigan P.A. of 1970, the corner points mentioned in lines 1 and 2 above were in conformance with regulations and rules therefore as required in the current manual of survey instructions of the United States Department of the Interior, Bureau of Land Management or by a decree of a Court of Law and/or that the corner points mentioned in lines 3, 4 and 5 above were in conformance with the rules of the Michigan Board of Land Surveyors or by a Decree of a Court of Law, established, re-established, monumented, re-monumented, recovered, found as expressed below.

**NOTE: Not more than 2 corners, all in the same town and range, may be recorded on this certificate.**

	A	B	C	D	E	F	G	H	I	J	K	L	M
2	6	5	4	3	2	1							
3													
4	7	8	9	10	11	12							
5													
6	18	17	16	15	14	13							
7													
8	19	20	21	22	23	24							
9													
10	30	29	28	27	26	25							
11													
12	31	32	33	34	35	36							
13													

**A. Description of original monument and accessories and/or subsequent restoration:**

- 1837 Hodson  
Set 1/4 Cor  
Hemlock 8 S79W 12  
Hemlock 10 S83E 10  
5-8-72 Lapham (132) 1-103  
Mon. Box in centerline Surrey Road  
7-10-74 Lapham, (132) 1-745  
References LCRC #118
- Circa 1900, Unknown CSR 6-14  
Tel. Pole 9 N9E 37 1/2  
Fence Post 7 S1E 50  
4-9-72 Urbaniak, (132) Dwg  
References S1/4 Cor.  
5-7-75 Meyers, (132) 1-991  
References LCRC #118
- Circa 1965 M.S.H.D, US10 R/W Plans 18024  
Fd 3" Tile raised w/ 5/8" x 30" sq. iron rod  
Approx. 1.3' N of Ctr. Rd  
S17°E 75.21 6" Maple  
S61°E 85.61 16" Maple  
Due South 33.22 Cor. Fe. Post  
Due North 34.54 Cor. Fe. Post  
Due South 11.45 EM  
Due North 8.70 EM  
9-14-73 Urbaniak, (132) 1-568  
Fd Mon. Box  
North 34.60 Fence Cor  
N70W 104.6 P.P.  
South 33.3 Fence Cor  
4-29-80 Lapham, (132) 2-556  
Fd. Mon. Box  
Same as (132) 1-568  
4-16-83 Urbaniak, (132) 2-791  
Same as (132) 1-568  
5-10-89 Lapham, (132) 3-125  
Same as (132) 1-568
- 5-1-72 Lapham LCRC #29  
Mon. Box in centerline Surrey Road  
10-24-73 Lapham, (132) 1-565  
Same as (132) 1-568  
7-22-91 Robison, (132) 3-307  
Meas. West 2621.13 to I-7  
Meas. East 2640.69 to K-7  
11-6-73 Lapham LCRC #118  
Same as (132) 1-568

**B. Description of corner evidence found and/or method applied in restoring or re-establishing corner:**


See dossier for detailed report.  
 Found 5/8" x 40" square iron in Mon. Box 2' N of C.L. Road. Fd four 1965 witnesses, three 1973 witnesses.

**C. Description of monument for corner and accessories established to perpetuate locating the position of the corner:**

Set 5/8" x 36" rered with Clare Co. Remon Cap marked P.S. #27458 existing Mon. Box. Accepted as best available evidence of the accepted position of the corner.

Witnesses:  
 S17°E 75.21 N & T in 14" Maple (OBT)  
 South 33.22 N & T in Cor. F. Post (OBT)  
 North 34.00 N & T in Cor. F. Post (OBT)  
 N63°E 81.10 N & T in New P.P.

Signed by Mark R. Robison  
 Surveyor's Michigan License No. 27458

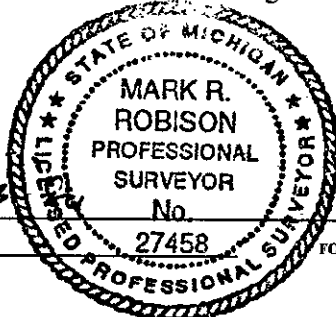

**APPROVED LAND CORNER**  
 P.A. 345 of 1990  
 Clare County

Chairman Paul S. Leph

Date 9-29-99

Date 11-8-99