

MAR 24 2000

LAND CORNER RECORDATION CERTIFICATE

Filing Requirement of Act 74, Mich. P.A. 1970

SECTION

Clare County Remonumentation 199900009775

Filed for Record in
CLARE COUNTY MICHIGAN
CAROL MCAULAY
On 11-10-1999 At 01:30 pm.
LAND CORNER 9.00
OR Liber 2 Page 54 - 54

For Corners in
Clare

(County)	Located In:	Corner Code#:
1. Public Land Survey	T. <u>17N</u> R. <u>5W</u>	<u>L-5</u>
	T. _____ R. _____	_____
	T. _____ R. _____	_____
2. Public Controlling in Section	S. _____ T. _____ R. _____	_____
	S. _____ T. _____ R. _____	_____
3. Miscellaneous Property in Section	S. _____ T. _____ R. _____	_____
	S. _____ T. _____ R. _____	_____
4. Lot No. _____, Recorded Plat		
5. Private Claims _____		

Instrument 199900009775 OR Liber 2 Page 54

365-99

Register of Deeds Stamp & File Number

I, Mark R. Robison, in a field survey on July 7, 1999, do hereby certify that under requirements of P.A. 74, Michigan P.A. of 1970, the corner points mentioned in lines 1 and 2 above were in conformance with regulations and rules therefore as required in the current manual of survey instructions of the United States Department of the Interior, Bureau of Land Management or by a decree of a Court of Law and/or that the corner points mentioned in lines 3, 4 and 5 above were in conformance with the rules of the Michigan Board of Land Surveyors or by a Decree of a Court of Law, established, re-established, monumented, re-monumented, recovered, found as expressed below.

NOTE: Not more than 2 corners, all in the same town and range, may be recorded on this certificate.

	A	B	C	D	E	F	G	H	I	J	K	L	M
1													
2	6	5	4	3	2	1							
3													
4	7	8	9	10	11	12							
5													
6	18	17	16	15	14	13							
7													
8	19	20	21	22	23	24							
9													
10	30	29	28	27	26	25							
11													
12	31	32	33	34	35	36							
13													

A. Description of original monument and accessories and/or subsequent restoration:


1837 Nicholson 40.10 set 1/4 Sec. Post Hemlock 20 S14E 07 Hemlock 18 S32W 35	1970 MSHD, Project 18024 Fd 4" x 42" Iron Pipe filled w/conc & Brass Capped 12" below surface. Set by Cons. Dept. in line with old fence remains N and in approx. C.L. of E-W Road. Meas. W. 2734.46 Meas. E. 2683.79 N08°E 39.95 8" W. Pine N52°E 53.18 4" R. Pine S12°W 38.27 8" Beech	1981 Lapham, (132) 2-646 & LCRC #402 Set 1/2" capped re-rod from MDOT Map North 96.10 10" W. Pine N15E 82.20 6" R. Pine N25E 81.15 6" R. Pine N40E 87.30 6" R. Pine Meas. E 2684.19
1916 Unknown, CSR 6 pg. 12 & 13 Pine Stp. 8" S89 1/2 W 8 Pine Stb. 20" N31W 44		1988 Lapham, (132) 2-289 Same as (132) 2-646
1948 Johnson, CSR 2-158 .Stake in old road, Old 1/4 Post		1991 Robison Fd 1/2" C.I. Same as (132) 2-646

B. Description of corner evidence found and/or method applied in restoring or re-establishing corner:
See dossier for detailed report.

Fd 1/2" x 18" C.I. & all 1981 witnesses. All M.S.H.D. witnesses have been removed for road construction & road has been cut about five feet. Found & removed spike 5.25 feet south of corner. Accepted C.I. for corner.

C. Description of monument for corner and accessories established to perpetuate locating the position of the corner
Set 5/8" x 36" re-rod with Clare Co. Remon Cap marked P.S. #27458 in C.L. Gravel Road. Accepted as best available evidence of the accepted position of the corner.

Witnesses:
North 96.06 Set N & T in 20" W. Pine (OBT)
N15°E 82.00 Set N & T in 13" R. Pine (OBT)
N27°E 81.22 Set N & T in 14" R. Pine (OBT)
N43°E 87.43 Set N & T in 12" R. Pine (OBT)

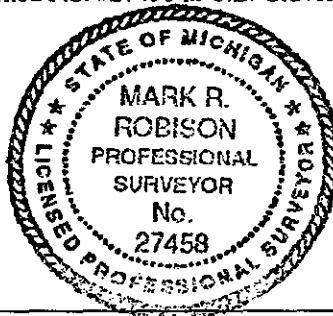

APPROVED LAND CORNER
P.A. 345 of 1990
Clare County

Chairman Paul D. Lepak
Date 9-29-99

Signed by Mark R. Robison
Surveyor's Michigan License No. 27458

Date 11-8-99