

**SURVEY &
REMONUMENTATION**

JAN 17 1996

**LAND CORNER RECORDATION CERTIFICATE
COMMISSION Filing Requirement of Act 74, Mich. P.A. 1970**

For corners in

<u>CLARE</u> (County)	Located In:	Corner Code #
1. Public Land Survey	T 17N R 5W	M-9
	T R	
	T R	
	T R	
2. Property Controlling In Section	S T R	
	S T R	
3. Miscellaneous Property in Sec.	S T R	
	S T R	

RECEIVED
7 133-95 A D
95 DEC 15 PM 3:30
REGISTER OF DEEDS
CLARE COUNTY
DONNA M. CARR

Register of Deeds Stamp & File Number

4. Lot No. _____, Recorded Plat _____
5. Private Claims _____

I, MARK R. ROBISON, in a field survey on NOVEMBER, 1995 do hereby state that under requirements of P.A. 74, Michigan P.A. of 1970, the corner points mentioned in lines 1 and 2 above were in conformance with regulations and rules therefore as required in the current manual of survey instructions of the United States Department of the Interior, Bureau of Land Management or by a decree of a Court of Law and /or that the corner points mentioned in lines 3, 4 and 5 above were in conformance with the rules of the Michigan Board of Land Surveyors or by a Decree of a Court of Law, established, re-established, monumented, recovered, found as expressed below:

NOTE: Not more than 2 corners, all in the same town and range, may be recorded on this certificate.

	A	B	C	D	E	F	G	H	I	J	K	L	M
1													
2	6		5		4		3		2		1		
3													
4	7		8		9		10		11		12		
5													
6	18		17		16		15		14		13		
7													
8	19		20		21		22		23		24		
9													
10	30		29		28		27		26		25		
11													
12	31		32		33		34		35		36		
13													

A. Description of original monument and accessories and/or subsequent restoration:

1837 JOHN HUDSON
WIT.-HEMLOCK 12" S63°W 43
BIRCH 14" N6 1/2°W 32

NO DATE, NO SURVEYOR
TILE, CINDERS & STAKE IN HWY.
B. HICKORY 8" N35°E 113 1/2

10-60 PAUL LAPHAM
FOUND IRON

9-73 PAUL LAPHAM
NO WITNESSES
DRAWING OF DESCRIPTION

1-77 LEONARD URBANIAK (132) SURVEY
FOUND CAPPED IRON
WIT.-S80°W 134.0' 40" ELM
S35°E 41.2' 24" MAPLE
S80°E 33.0' 14" MAPLE

2-77 PAUL LAPHAM UNRECORDED SURVEY
FOUND CAPPED IRON
WIT.-S80° 134.0' 40" ELM
S35°E 41.2' 24" MAPLE
S80°E 33.0' 14" MAPLE

11-77 PAUL LAPHAM L.C.R.C. 306
SAME AS ABOVE

3-82 MARK ROBISON (132) SURVEY
FOUND CAPPED IRON
SAME AS ABOVE

4-82 PAUL LAPHAM
FOUND CAPPED IRON
SAME AS ABOVE

B. Description of corner evidence found and/or method applied in restoring or reestablishing corner:

FOUND 1/2"x21" RE-ROD IN MONUMENT BOX IN ASPHALT PVM'T, RETRACED UN-RECORDED SURVEY DATED 2-1-77 AND VERIFIED THE POSITION OF THE CORNER. ALL WITNESSES GONE DUE TO ROAD CONSTRUCTION.

APPROVED LAND CORNER
P.A. 345 of 1980
Clare County

Chairman Paul S. Lapham

Date 12-12-95


This Corner established in Clare County Remonumentation Program.

See dossier for detailed report.

C. Description of monument for corner and accessories established to perpetuate locating the position of the corner:

M-9: 24-25 SECTION CORNER ON TOWNSHIP LINE
SET 5/8"x36" RE-ROD WITH 3" CLARE COUNTY MONUMENT CAP IN MONUMENT BOX.
ACCEPTED AS BEST AVAILABLE EVIDENCE OF THE ACCEPTED POSITION OF THE CORNER.

WITNESSES:
N80°W 108.90' - NAIL & TAG IN TWIN 20" BASSWOOD
N07°E 62.78' - NAIL & TAG IN POWER POLE
SOUTH 58.12' - NAIL & TAG IN 5" ASH
SOUTH 33.00' CAPPED IRON FROM 2-1-77 SURVEY
S35°E 72.08' - NAIL & TAG IN 28" MAPLE

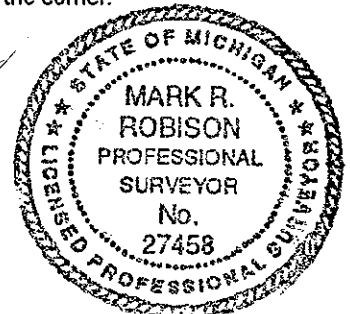

Signed by Mark R. Robison
Surveyor's Michigan License No. 27458

Date 12-13-95