


LAND CORNER RECORDATION CERTIFICATE

Filing Requirement of Act 74, Mich. PA 1970

For Corners In: <u>Clare</u> (County)	Located In _____	Corner Code # _____
1. Public Land Survey	T <u>17N</u> R <u>5W</u>	<u>D12</u>
	T _____ R _____	_____
2. Property Controlling in Section	S _____ T _____ R _____	_____
	S _____ T _____ R _____	_____
3. Miscellaneous Property in Section	S _____ T _____ R _____	_____
	S _____ T _____ R _____	_____
4. Lot No: _____	Recorded Plat: _____	
5. Private Claims: _____		

Register of Deeds Stamp & File Number

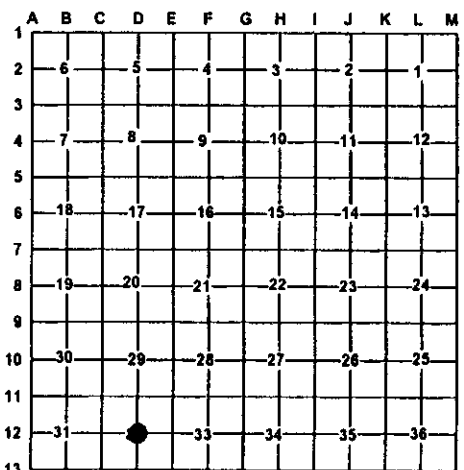

I, Craig W. McVean, in a field survey on August 8, 2000 do hereby state that under requirements of PA 74, Michigan PA of 1970, the corner points mentioned in lines 1 and 2 above were in conformance with regulations and rules therefore as required in the current manual of survey instructions of the United States Department of the Interior, Bureau of Land Management or by a decree of a Court of Law and/or that the corner points mentioned in lines 3, 4 and 5 above were in conformance with the rules of the Michigan Board of Land Surveyors or by a Decree of a Court of Law; established, re-established, monumented, recovered, found as expressed below:

NOTE: Not more than 2 corners, all in the same town and range, may be recorded on this certificate.

A. Description of original monument and accessories and/or subsequent restoration:
D12-None

B. Description of corner evidence found and/or method applies in restoring or re-establishing corner:
D12-C 1/4, Sec. 32 - Set 3 1/2" DNR Aluminum Cap on 1" x 36" Galv. Iron Pipe at intersection of 1/4 lines in swamp. DNR Mon. accepted as the best available evidence of the position of the corner.

C. Description of monument for corner and accessories established to perpetuate locating the position of the corner:
D12-DNR Monument. Add Ring of Stone

- Set Blue Carsonite Post w/ Loc. Tag 1' NE
- N27°W 20.39' to N&T in W. side 9" Cedar scribed 'XBT'
- N64°W 26.74' to N&T in S. side 8" Hemlock scribed 'XBT'
- S14°W 41.54' to N&T in W. side 11" Cedar scribed 'XBT'
- N32°E 35.48' to N&T in W side 8" R. Maple scribed 'XBT'

DNR Mon. used & accepted in place of Clare Co. Remon. Mon.



Signed by: Craig W. McVean
 Surveyor's Michigan License No.: 39088

Date: 10/18/2000