

LAND CORNER RECORDATION CERTIFICATE

Filing Requirement of Act 74, Mich. PA 1970

For Corners In:		
<u>Clare</u>	Located In	Corner Code #
(County)		
1. Public Land Survey	T <u>17N</u> R <u>5W</u>	<u>F10</u>
	T _____ R _____	_____
2. Property Controlling in Section	S _____ T _____ R _____	_____
	S _____ T _____ R _____	_____
3. Miscellaneous Property in Section	S _____ T _____ R _____	_____
	S _____ T _____ R _____	_____


Register of Deeds Stamp & File Number

4. Lot No: _____ Recorded Plat: _____

5. Private Claims: _____

I, Craig W. McVean, in a field survey on July 27, 2000 do hereby state that under requirements of PA 74, Michigan PA of 1970, the corner points mentioned in lines 1 and 2 above were in conformance with regulations and rules therefore as required in the current manual of survey instructions of the United States Department of the Interior, Bureau of Land Management or by a decree of a Court of Law and/or that the corner points mentioned in lines 3, 4 and 5 above were in conformance with the rules of the Michigan Board of Land Surveyors or by a Decree of a Court of Law; established, re-established, monumented, recovered, found as expressed below:

NOTE: Not more than 2 corners, all in the same town and range, may be recorded on this certificate.

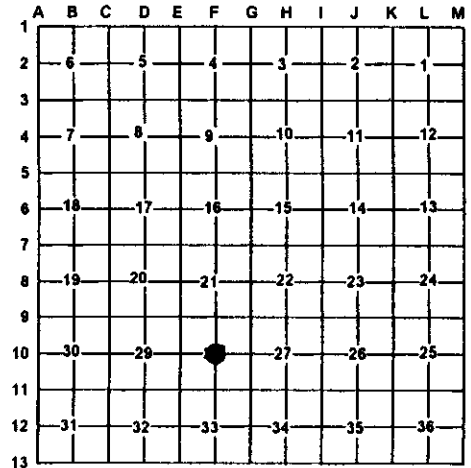

A. Description of original monument and accessories and/or subsequent restoration:
F10-None

B. Description of corner evidence found and/or method applies in restoring or re-establishing corner:
F10-C 1/4, Sec. 28-Set 4" DNR Alum. Cap on 1" x 36" Galv. Iron Pipe in ring of stone at intersection of 1/4 lines in swamp.
DNR Monument accepted as the best available evidence of the position of the corner.

C. Description of monument for corner and accessories established to perpetuate locating the position of the corner:
F10- 4" DNR Alum Cap on 1" x 36" Iron Pipe

- Set Blue Carsonite Post 1' SE
- N23°E 37.94' to N & T in W side 14" Cedar scribed 'XBT'
- N58°E 13.71' to N & T in SE side 8" Hemlock scribed 'XBT'
- S50°E 43.65' to N & T in SW side 6" R. Maple scribed 'XBT'
- N87°W 18.82' to N & T in N side 9" Cedar scribed 'XBT'

DNR Mon. used & accepted in place of Clare Co. Remon. Mon.



Signed by: Craig W. McVean
Surveyor's Michigan License No.: 39088

Date: 10/18/2000