

LAND CORNER RECORDATION CERTIFICATE


Filing Requirement of Act 74, Mich. PA 1970

For Corners In: <u>Clare</u> (County)	Located In	Corner Code #
1. Public Land Survey	T <u>17N</u> R <u>5W</u>	<u>F11</u>
2. Property Controlling in Section	S _____ T _____ R _____	_____
3. Miscellaneous Property in Section	S _____ T _____ R _____	_____
4. Lot No: _____	Recorded Plat: _____	
5. Private Claims: _____		

Register of Deeds Stamp & File Number

I, Craig W. McVean, in a field survey on July 20, 2000 do hereby state that under requirements of PA 74, Michigan PA of 1970, the corner points mentioned in lines 1 and 2 above were in conformance with regulations and rules therefore as required in the current manual of survey instructions of the United States Department of the Interior, Bureau of Land Management or by a decree of a Court of Law and/or that the corner points mentioned in lines 3, 4 and 5 above were in conformance with the rules of the Michigan Board of Land Surveyors or by a Decree of a Court of Law; established, re-established, monumented, recovered, found as expressed below:

NOTE: Not more than 2 corners, all in the same town and range, may be recorded on this certificate.

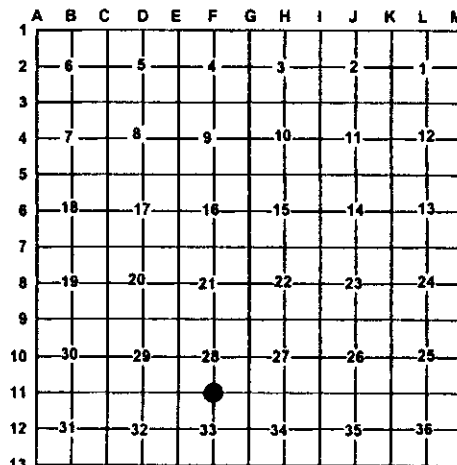

A. Description of original monument and accessories and/or subsequent restoration:

F11-GLO- Set 1/4 post-H. Nicholson-1837
 Cedar 8" S62°W 19 L.
 Hemlock 6" N56°E 39 L.
 -CSR-Bk.6, P.33-Cedar 4" N72°W 16 L.
 -Cedar 3" S50°W 22 1/2 L.

B. Description of corner evidence found and/or method applies in restoring or re-establishing corner:

F11-1/4 corner common to Sec. 28 & 33-Could find no evidence of GLO or Co. Survey Record BT's. All Cedar & other trees in swamp were cut 10 years + ago. Set 4" DNR Alum. Cap on 1" x 5' long galv. Iron pipe at Single Proportional position on line between E11 & G11. DNR Mon. accepted a careful & faithful re-establishment of the position of the original corner.

C. Description of monument for corner and accessories established to perpetuate locating the position of the corner:

F11-DNR Monument
 Set Blue Carsonite Post 1"N
 East 55.75' to N&T in S side 26" WPS scribed 'XBT'
 S52°E 37.16' to N&T in SW side 4" Fir scribed 'XBT'
 S36°W 20.05' to N&T in NW side 3" Fir scribed 'XBT'
 N3°E 5.23' to N&T in W side 4" Fir scribed 'XBT'

DNR Mon. used & accepted in place of Clare Co. Remon. Mon.



Signed by: Craig W. McVean
 Surveyor's Michigan License No.: 39088

Date: 10/18/2000