


LAND CORNER RECORDATION CERTIFICATE


Filing Requirement of Act 74, Mich. PA 1970

For Corners In:		
Clare	Located In	Corner Code #
(County)		
1. Public Land Survey	T 17N R 6W	G6
	T _____ R _____	_____
2. Property Controlling in Section	S T R	_____
	S _____ T _____ R _____	_____
3. Miscellaneous Property in Section	S T R	_____
	S _____ T _____ R _____	_____
4. Lot No: _____	Recorded Plat: _____	
5. Private Claims: _____		

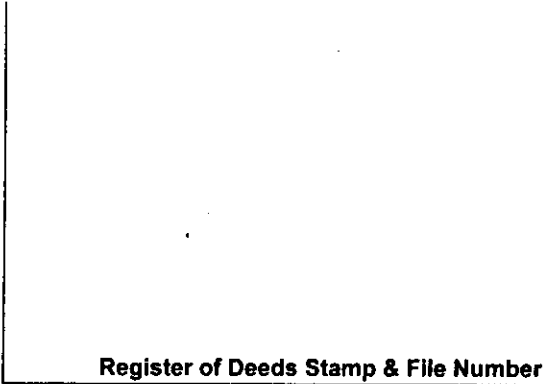

I, Craig W. McVean, in a field survey on January 19, 1999 do hereby state that under requirements of PA 74, Michigan PA of 1970, the corner points mentioned in lines 1 and 2 above were in conformance with regulations and rules therefore as required in the current manual of survey instructions of the United States Department of the Interior, Bureau of Land Management or by a decree of a Court of Law and/or that the corner points mentioned in lines 3, 4 and 5 above were in conformance with the rules of the Michigan Board of Land Surveyors or by a Decree of a Court of Law; established, re-established, monumented, recovered, found as expressed below:

NOTE: Not more than 2 corners, all in the same town and range, may be recorded on this certificate.

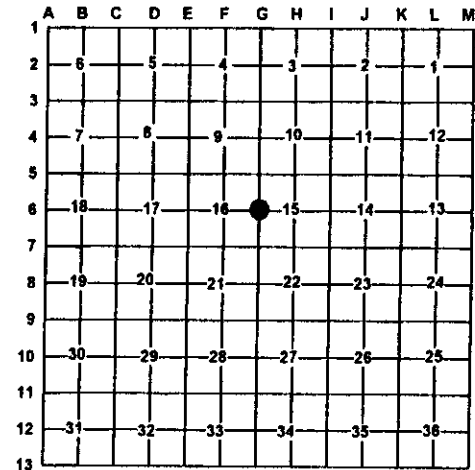

A. Description of original monument and accessories and/or subsequent restoration:

- G6- GLO- Set 1/4 post - Orson Lyon-1847
Norway Pine 18" N27.5°E 14 L.
Beech 12" N68°W 23 L.
- CSR Bk. 6, P. 160-Iron bolt in cedar post 4" clay tile, Lag in Fence post N 2°E 40.24', Lag in corner post S87°E 12.41', 10" Pine Stp. S40°E 58.90'
- Plat of "Ormans Garfield Acres"- F. McClung-1953-concrete plat mon.
- LCRC #237-76-P. Lapham-1976- Fnd. 3/4" pipe, N80°E 50.85' 6" post, N80°W 32.08'- 6" post, S40°W 76.04' 5" Oak, North 3.60'-6" post

B. Description of corner evidence found and/or method applies in restoring or re-establishing corner:

G-6 - 1/4 corner common to Sections 16 & 15- Fnd. 3/4" I.D. Iron pipe per LCRC that fits the plat. Didn't find any evidence of monument per County Survey Record. Newer E-W fence is 3.7' N. 3/4" pipe accepted as the best available evidence of the position of the original corner.

C. Description of monument for corner and accessories established to perpetuate locating the position of the corner:

- G-6 - 3/4" Iron Pipe.
- Add Orange Carsonite Post 1' N.
- S75°E 37.85' to set nail and tag in N. side of 7" Pine
- N86°E 30.75' to set nail and tag in S. side of 7" Cedar Post
- N49°W 5.83' to set nail and tag in E. side of 7" Cedar Post
- West 0.3' to face of 7" Cedar Post
- S E 121.93' to NW Deck Support



Signed by: Craig W. McVean
Surveyor's Michigan License No.: 39088

Date: 10/18/2000