

**SURVEY &
REMONUMENTATION**

FEB 18 1994 CLARE COUNTY REMONUMENTATION PROGRAM

COMMISSION

**LAND CORNER RECORDATION CERTIFICATE
Filing Requirement of Act 74, Mich. P.A. 1970**

For corners in

<u>CLARE</u> (County)	Located In:	Corner Code #
1. Public Land Survey	T <u>17N</u> R <u>6W</u>	<u>C-11</u>
	T _____ R _____	_____
	T _____ R _____	_____
	T _____ R _____	_____
2. Property Controlling in Section	S _____ T _____ R _____	_____
	S _____ T _____ R _____	_____
3. Miscellaneous Property in Sec.	S _____ T _____ R _____	_____
	S _____ T _____ R _____	_____

RECEIVED
E 10 A 10
1993 DEC 20 PM 1:45
REGISTER OF DEEDS
CLARE COUNTY
DONNA M CARR

Register of Deeds Stamp & File Number

4. Lot No. _____, Recorded Plat _____
5. Private Claims _____

	A	B	C	D	E	F	G	H	I	J	K	L	M
2	6	5	4	3	2	1							
3													
4	7	8	9	10	11	12							
5													
6	18	17	16	15	14	13							
7													
8	19	20	21	22	23	24							
9													
10	30	29	28	27	26	25							
11													
12	31	32	33	34	35	36							
13													

I, MARK R. ROBISON, in a field survey on OCTOBER, 19 93, do hereby certify that under requirements of P.A. 74, Michigan P.A. of 1970, the corner points mentioned in lines 1 and 2 above were in conformance with regulations and rules therefore as required in the current manual of survey instructions of the United States Department of the Interior, Bureau of Land Management or by a decree of a Court of Law and/or that the corner points mentioned in lines 3, 4 and 5 above were in conformance with the rules of the Michigan Board of Land Surveyors or by a Decree of a Court of Law; established, re-established, monumented, re-monumented, recovered, found as expressed below:


NOTE: Not more than 4 corners, all in the same town and range, may be recorded on this certificate.

A. Description of original monument and accessories and/or subsequent restoration:
1847 ORSON LYON, POST, BLACK ASH 12" N 57°W, 18 LKS P.338
BLACK ASH 12" N 46°E, 12 LKS
11-10-77 LAPHAM, LCRC 307-77

B. Description of corner evidence found and/or method applied in restoring or reestablishing corner:
FOUND 1/2" x 18" REBAR & 5/8" x 15" SUCKER ROD & 3" x 12" POINTED CEDAR POST (NOT ANCIENT).
DID NOT FIND 1" PIPE REFERENCED IN LCRC 307-77.
FOUND RECORDED WITNESSES:
N 15°E, 27.50' - WILLOW
S 30°E, 29.02' - WILLOW
S 30°W, 37.20' - MAPLE

This Corner established in Clare County Remonumentation Program.
See dossier for detailed report.

C. Description of monument for corner and accessories established to perpetuate locating the position of the corner:
SET 5/8" X 36" RE-ROD WITH 3" CLARE COUNTY MONUMENT CAP.
N 15°E, 26.90' - 12" WILLOW
S 30°E, 29.12' - 14" WILLOW
WEST, 33.00' - CAPPED IRON STAKE
S 30°W, 37.28' - 10" MAPLE STUMP
N 60°W, 25.11' - 4" ELM

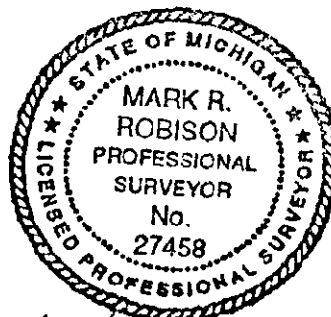

Signed by Mark R. Robison

Date 11/24/93

Surveyor's Michigan License No. 27458