

**SURVEY & REMONUMENTATION**

**JAN 23 2001**

**SECTION**

**LAND CORNER RECORDATION CERTIFICATE**

**Filing Requirement of Act 74, Mich. P.A. 1970**

**Clare County Remonumentation**

For Corners in  
Clare

(County)

Located In:

Corner Code#:

- 1. Public Land Survey T. 17N R. 6W E-13  
T. \_\_\_\_\_ R. \_\_\_\_\_  
T. \_\_\_\_\_ R. \_\_\_\_\_
- 2. Public Controlling S. \_\_\_\_\_ T. \_\_\_\_\_ R. \_\_\_\_\_  
in Section S. \_\_\_\_\_ T. \_\_\_\_\_ R. \_\_\_\_\_
- 3. Miscellaneous S. \_\_\_\_\_ T. \_\_\_\_\_ R. \_\_\_\_\_  
Property in Section S. \_\_\_\_\_ T. \_\_\_\_\_ R. \_\_\_\_\_
- 4. Lot No. \_\_\_\_\_, Recorded Plat \_\_\_\_\_
- 5. Private Claims \_\_\_\_\_

200000010150  
Filed for Record in  
CLARE COUNTY MICHIGAN  
CAROL MCAULAY  
On 12-15-2000 At 07:44 am.  
LAND CORNER 9.00  
OR Liber 2 Page 273 - 273

Instrument Liber Page  
200000010150 OR 2 273

# 478-00

Register of Deeds Stamp & File Number

I, Jan S. Fokens, in a field survey on March 6, 2000, do hereby certify that under requirements of P.A. 74, Michigan P.A. of 1970, the corner points mentioned in lines 1 and 2 above were in conformance with regulations and rules therefore as required in the current manual of survey instructions of the United States Department of the Interior, Bureau of Land Management or by a decree of a Court of Law and/or that the corner points mentioned in lines 3, 4 and 5 above were in conformance with the rules of the Michigan Board of Land Surveyors or by a Decree of a Court of Law, established, re-established, monumented, re-monumented, recovered, found as expressed below.

**NOTE: Not more than 2 corners, all in the same town and range, may be recorded on this certificate.**

1	A	B	C	D	E	F	G	H	I	J	K	L	M
2	6	5	4	3	2	1							
3													
4	7	8	9	10	11	12							
5													
6	18	17	16	15	14	13							
7													
8	19	20	21	22	23	24							
9													
10	30	29	28	27	26	25							
11													
12	31	32	33	34	35	36							
13													

A. Description of original monument and accessories and/or subsequent restoration:

- 1. G.L.O Original Survey:  
Township: 2<sup>nd</sup> Quarter, 1837 John Hodgson  
Pages 298, 331 original field notes
- 2. County Survey Records:  
None of Record
- 3. L.C.R.C.:  
Liber 465, Page 85 Paul B. Lapham 1984 Set 1/2" capped re-rod  
Liber 887, Page 99 Mark Robison 1999 Found 1/2" iron
- 4. Surveys of Record:  
None of Record
- 5. Unrecorded Survey:  
Paul B. Lapham & Assoc. survey 1988 Found 1/2" iron  
Paul B. Lapham & Assoc. field notes 1989 Distances noted  
Paul B. Lapham & Assoc. survey 1999 Found 1/2" iron  
Paul B. Lapham & Assoc. survey 1999 Found 1/2" iron

APPROVED LAND CORNER  
P.A. 945 of 1990  
Clare County  
Chairman *Paul B. Lapham*  
Date 9-13-00

B. Description of corner evidence found and/or method applied in restoring or re-establishing corner:

- Existent corner established in the Clare County Remonumentation Program. See dossier for detailed report.
- 1. Found 1/2" iron 6' ± South of centerline of road East/West on centerline of road to North
- 2. Excavated 2.5'. Found no further evidence.


Accepted as the best available evidence of the position of the original corner and replaced with Standard Monument Corner.

C. Description of monument for corner and accessories established to perpetuate locating the position of the corner:  
Set Standard Clare County Monument in Monument Box, stamped E-13/17-6 and E-1/16-6 and PS 21567.

- E-13 Corner common to sections 32 and 33, T.17N.-R.6W., Garfield Township, Clare Co., MI.**
- N.25°E. 60.83' Found pk nail with disk #28417 in East face of corner fence post
- East 103.27' Re-rod with cap #21567, property controlling corner
- N.22°E. 98.22' Set nail and tag in West face of 10" Poplar
- S.40°E. 59.43' Found pk nail with disk #28417 in NE face of corner fence post
- S.10°W. 12.68' West edge of West leg of road directional sign
- N.89°38'31"W. 2646.12' D-13 S. 1/4 Corner, Section 32, T.17N.-R.6W., Garfield Twp., Clare Co., MI.
- S.89°48'07"E. 2654.36' F-13 S.1/4 Corner, Section 33, T.17N.-R.6W., Garfield Twp., Clare Co., MI.

Signed by

Surveyor's Michigan

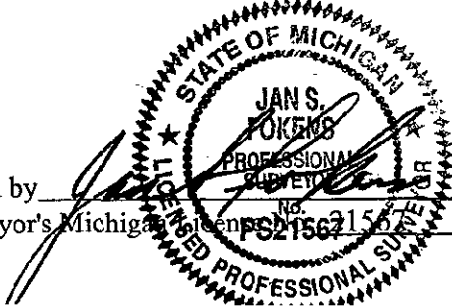

Date

12/12/00