

SURVEY & REMONUMENTATION

JAN 23 2001

SECTION

LAND CORNER RECORDATION CERTIFICATE
Filing Requirement of Act 74, Mich. P.A. 1970
Clare County Remonumentation

For Corners in
Clare
 (County)

	Located In:	Corner Code#:
1. Public Land Survey	T. <u>17N</u> R. <u>6W</u>	<u>F-13</u>
	T. _____ R. _____	_____
	T. _____ R. _____	_____
2. Public Controlling in Section	S. _____ T. _____ R. _____	_____
	S. _____ T. _____ R. _____	_____
3. Miscellaneous Property in Section	S. _____ T. _____ R. _____	_____
	S. _____ T. _____ R. _____	_____
4. Lot No. _____, Recorded Plat _____		
5. Private Claims _____		

200000010151
 Filed for Record in
 CLARE COUNTY MICHIGAN
 CAROL MCAULAY
 On 12-15-2000 At 07:44 am.
 LAND CORNER 9.00
 OR Liber 2 Page 274 - 274

Instrument Liber Page
 200000010151 OR 2 274

479-00

Register of Deeds Stamp & File Number

I, Jan S. Fokens, in a field survey on March 6, 2000, do hereby certify that under requirements of P.A. 74, Michigan P.A. of 1970, the corner points mentioned in lines 1 and 2 above were in conformance with regulations and rules therefore as required in the current manual of survey instructions of the United States Department of the Interior, Bureau of Land Management or by a decree of a Court of Law and/or that the corner points mentioned in lines 3, 4 and 5 above were in conformance with the rules of the Michigan Board of Land Surveyors or by a Decree of a Court of Law, established, re-established, monumented, re-monumented, recovered, found as expressed below.

NOTE: Not more than 2 corners, all in the same town and range, may be recorded on this certificate.

	A	B	C	D	E	F	G	H	I	J	K	L	M
1													
2	6	5	4	3	2	1							
3													
4	7	8	9	10	11	12							
5													
6	18	17	16	15	14	13							
7													
8	19	20	21	22	23	24							
9													
10	30	29	28	27	26	25							
11													
12	31	32	33	34	35	36							
13													

A. Description of original monument and accessories and/or subsequent restoration: -

- G.L.O Original Survey:
 Township: 2nd Quarter, 1837 John Hodgson
 Pages 298 original field notes
- County Survey Records:
 None of Record
- L.C.R.C.:
 None of Record
- Surveys of Record:
 None of Record
- Unrecorded Survey:
 Paul B. Lapham & Assoc. field notes 1989 Found 1/2" iron

APPROVED LAND CORNER
 P.A. 545 of 1990
 Clare County
 Chairman Paul B. Lapham
 Date 9-13-00


B. Description of corner evidence found and/or method applied in restoring or re-establishing corner:

- Existent corner established in the Clare County Remonumentation Program. See dossier for detailed report.
- Found 3/8" iron 3' south of centerline of road
 - Excavated to 2.5. Found no further evidence
- Note: Found iron does not fit occupied line to south.

Accepted as the best available evidence of the position of the original corner and replaced with Standard Monument Corner.

C. Description of monument for corner and accessories established to perpetuate locating the position of the corner:
 Set Standard Clare County Monument in Monument Box, stamped F-13/17-6 and F-1/16-6 and PS 21567.

- F-13 S. 1/4 Corner, Section 33, T.17N.-R.6W., Garfield Township, Clare Co., MI.**
- N.30°W 50.17' Found pk & disc in NE face of 24" Red pine
 - N.50°E. 39.53' Found pk & disc in SE face of 24" Red pine
 - S.55°E. 38.05' Found pk & disc in NW face of 18" Spruce
 - S.32°E. 23.96' Set nail and tag in SW face of 12" Poplar
 - N.89°48'07"W. 2654.36' E-13 Corner common to sections 32 & 33, T.17N.-R.6W., Garfield Township, Clare County, MI.
 - S.89°48'18"E. 2654.09' G-13 Corner common to sections 33 & 34, T.17N.-R.6W., Garfield Township, Clare County, MI.

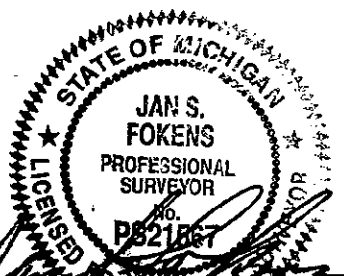

Signed by _____
 Surveyor's Michigan License No. 21567

Date 12/12/00