

SURVEY & REMONUMENTATION

FEB 18 1994

CLARE COUNTY REMONUMENTATION PROGRAM

COMMISSION

**LAND CORNER RECORDATION CERTIFICATE
Filing Requirement of Act 74, Mich. P.A. 1970**

For corners in

CLARE (County)	Located In:	Corner Code #
1. Public Land Survey	T <u>17N</u> R <u>6W</u>	<u>G-7</u>
	T _____ R _____	_____
	T _____ R _____	_____
	T _____ R _____	_____
2. Property Controlling in Section	S _____ T _____ R _____	_____
	S _____ T _____ R _____	_____
3. Miscellaneous Property in Sec.	S _____ T _____ R _____	_____
	S _____ T _____ R _____	_____
4. Lot No. _____, Recorded Plat _____		
5. Private Claims _____		

RECEIVED
E 10 A
1993 DEC 20 PM 1:44
REGISTER OF DEEDS
CLARE COUNTY
DONNA M. CARR

Register of Deeds Stamp & File Number

I, MARK R. ROBISON, in a field survey on OCTOBER, 19 93, do hereby certify that under requirements of P.A. 74, Michigan P.A. of 1970, the corner points mentioned in lines 1 and 2 above were in conformance with regulations and rules therefore as required in the current manual of survey instructions of the United States Department of the Interior, Bureau of Land Management or by a decree of a Court of Law and/or that the corner points mentioned in lines 3, 4 and 5 above were in conformance with the rules of the Michigan Board of Land Surveyors or by a Decree of a Court of Law; established, re-established, monumented, re-monumented, recovered, found as expressed below:

	A	B	C	D	E	F	G	H	I	J	K	L	M
2	6	5	4	3	2	1							
3													
4	7	8	9	10	11	12							
5													
6	18	17	16	15	14	13							
7													
8	19	20	21	22	23	24							
9													
10	30	29	28	27	26	25							
11													
12	31	32	33	34	35	36							
13													

NOTE: Not more than 4 corners, all in the same town and range, may be recorded on this certificate.

- A. Description of original monument and accessories and/or subsequent restoration:
- 1847 ORSON LYON, PINE 11" S 6-1/2"E, 37 LKS P.327
TAMARACK 12" N 41-3/4"W, 48 LKS
 - 6-20-08 JOHNSON, CEDAR 10" N 31"W, 62 LKS CSR 4-140
TAMARACK 10" N 52"E, 39 LKS CSR 6-166
 - 9-21-66 LAPHAM, PLAT OF SUNRISE HILLS #2 8-30
 - 10-18-67 LAPHAM, PLAT OF SUNRISE HILLS #3 8-56
 - 2-14-74 LAPHAM, LCRC 142-74
 - 10-17-76 WHITTIER, FOUND R.R. SPIKE, LCRC 217-75
 - 9-27-84 LAPHAM, 1/2" RE-ROD, LCRC 467-85


- B. Description of corner evidence found and/or method applied in restoring or reestablishing corner:

FOUND 1/2" x 18" IRON 5± SOUTH OF Q MYSTIC LAKE ROAD IN Q OF COOK AVENUE TO SOUTH. DID NOT FIND ANY WITNESSES TO CORNER. EXCAVATED CORNER & GOT REACTION 1-1/2± S.W. OF IRON. SURVEYED FROM PLAT OF SUNRISE HILLS #2 AND FOUND 1/2" x 18" IRON 1-1/2' S.W. OF FIRST IRON AND APPROXIMATELY 1' BELOW ASPHALT. EXCAVATED FURTHER & FOUND 1/2" IRON APPROXIMATELY 3-1/2' BELOW ASPHALT IN GROUND WATER. IRON FIT THE PLAT OF SUNRISE HILLS #2 & MEASURED 2584.00' (PLATTED 2584.93' SUNRISE HILLS #3) FROM NORTH 1/4 CORNER, SECTION 22. SET 5/8" x 36" RE-ROD WITH CLARE COUNTY REMONUMENTATION CAP AT THIS POINT IN MONUMENT BOX.

This Corner established in Clare County Remonumentation Program.
See dossier for detailed report.

- C. Description of monument for corner and accessories established to perpetuate locating the position of the corner:

SET 5/8" X 36" RE-ROD WITH 3" CLARE COUNTY MONUMENT CAP IN MONUMENT BOX.
N 65°E, 88.70' - 6" ELM
S 20°E, 139.80' - 5" OAK
S 40°W, 50.95' - POWER POLE
NORTH, 6.0' - Q ASPHALT PAVEMENT

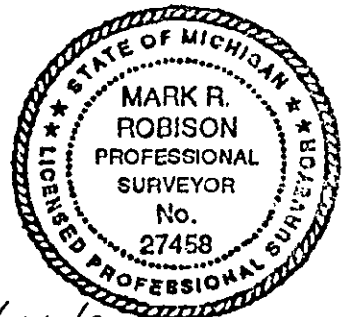

Signed by Mark R. Robison

Date 11/24/93

Surveyor's Michigan License No. 27458