

SURVEY & REMONUMENTATION

CLARE COUNTY REMONUMENTATION PROGRAM

FEB 18 1994

LAND CORNER RECORDATION CERTIFICATE
Filing Requirement of Act 74, Mich. P.A. 1970

For corners in _____

| | | |
|------------------------------------|--------------------------|----------------|
| <u>CLARE</u> (County) | Located in: | Corner Code #: |
| 1. Public Land Survey | T <u>17N</u> R <u>6W</u> | <u>H-7</u> |
| | T _____ R _____ | _____ |
| | T _____ R _____ | _____ |
| | T _____ R _____ | _____ |
| 2. Property Controlling in Section | S _____ T _____ R _____ | _____ |
| | S _____ T _____ R _____ | _____ |
| 3. Miscellaneous Property in Sec. | S _____ T _____ R _____ | _____ |
| | S _____ T _____ R _____ | _____ |

RECEIVED
 E □ 1 □ A □
 1993 DEC 20 PM 1:44
 REGISTER OF DEEDS
 CLARE COUNTY
 DONNA M. CARR

Register of Deeds Stamp & File Number

4. Lot No. _____, Recorded Plat _____
 5. Private Claims _____

| A | B | C | D | E | F | G | H | I | J | K | L | M |
|----|----|----|----|----|----|----|---|---|---|---|---|---|
| 2 | 6 | 5 | 4 | 3 | 2 | 1 | | | | | | |
| 3 | | | | | | | | | | | | |
| 4 | 7 | 8 | 9 | 10 | 11 | 12 | | | | | | |
| 5 | | | | | | | | | | | | |
| 6 | 18 | 17 | 16 | 15 | 14 | 13 | | | | | | |
| 7 | | | | | | | | | | | | |
| 8 | 19 | 20 | 21 | 22 | 23 | 24 | | | | | | |
| 9 | | | | | | | | | | | | |
| 10 | 30 | 29 | 28 | 27 | 26 | 25 | | | | | | |
| 11 | | | | | | | | | | | | |
| 12 | 31 | 32 | 33 | 34 | 35 | 36 | | | | | | |
| 13 | | | | | | | | | | | | |

I, MARK R. ROBISON, in a field survey on OCTOBER, 19 93, do hereby certify that under requirements of P.A. 74, Michigan P.A. of 1970, the corner points mentioned in lines 1 and 2 above were in conformance with regulations and rules therefore as required in the current manual of survey instructions of the United States Department of the Interior, Bureau of Land Management or by a decree of a Court of Law and/or that the corner points mentioned in lines 3, 4 and 5 above were in conformance with the rules of the Michigan Board of Land Surveyors or by a Decree of a Court of Law; established, re-established, monumented, re-monumented, recovered, found as expressed below:


NOTE: Not more than 4 corners, all in the same town and range, may be recorded on this certificate.

A. Description of original monument and accessories and/or subsequent restoration:
 1847 ORSON LYON, POST, BIRCH 8" N 27°W, 15 LKS P.328
 BIRCH 9" S 41-1/2°E, 26 LKS
 10-2-72 LAPHAM, LCRC 58-72
 1-7-73 LAPHAM, LCRC 128-74

B. Description of corner evidence found and/or method applied in restoring or reestablishing corner:
 FOUND 1/2" x 15" IRON OVER 3/4" x 2" PIPE IN GOOD CONDITION BUT VERY RUSTY. REMOVED AND REPLACED WITH 5/8" x 36" RE-BAR.
 FOUND CAPPED IRON 33.0' SOUTH OF CORNER.
 FOUND RECORDED WITNESSES:
 S 20°E, 46.6' - POWER POLE
 SOUTH, 64.5' - 15" MAPLE

This Corner established in Clare County Remonumentation Program.
 See dossier for detailed report.

C. Description of monument for corner and accessories established to perpetuate locating the position of the corner:
 SET 5/8" X 36" RE-ROD WITH 3" CLARE COUNTY MONUMENT CAP. SET MONUMENT BOX
 N 45°W, 74.7' - 8" OAK
 N 15°E, 76.1' - 10" PINE
 S 20°E, 46.58' - POWER POLE
 S 55°W, 70.69' - N.W. COR. BLDG.

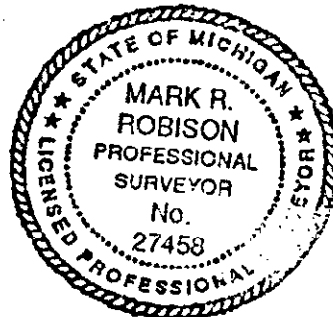

Signed by Mark R. Robison Date 11/30/93
 Surveyor's Michigan License No. 27458