

SURVEY & REMONUMENTATION

JAN 28 2001

SECTION

LAND CORNER RECORDATION CERTIFICATE
Filing Requirement of Act 74, Mich. P.A. 1970
Clare County Remonumentation

For Corners in
Clare

(County)

Located In:

Corner Code#:

- 1. Public Land Survey T. 17N R. 6W I-13
 T. _____ R. _____
 T. _____ R. _____
- 2. Public Controlling S. _____ T. _____ R. _____
 in Section S. _____ T. _____ R. _____
- 3. Miscellaneous S. _____ T. _____ R. _____
 Property in Section S. _____ T. _____ R. _____
- 4. Lot No. _____, Recorded Plat _____
- 5. Private Claims _____

200000010154
 Filed for Record in
 CLARE COUNTY MICHIGAN
 CAROL MCAULAY
 On 12-15-2000 At 07:44 am.
 LAND CORNER 9.00
 OR Liber 2 Page 277 - 277

Instrument Liber Page
 200000010154 OR 2 277

482-00

Register of Deeds Stamp & File Number

I, Jan S. Fokens, in a field survey on April 12, 2000, do hereby certify that under requirements of P.A. 74, Michigan P.A. of 1970, the corner points mentioned in lines 1 and 2 above were in conformance with regulations and rules therefore as required in the current manual of survey instructions of the United States Department of the Interior, Bureau of Land Management or by a decree of a Court of Law and/or that the corner points mentioned in lines 3, 4 and 5 above were in conformance with the rules of the Michigan Board of Land Surveyors or by a Decree of a Court of Law, established, re-established, monumented, re-monumented, recovered, found as expressed below.

NOTE: Not more than 2 corners, all in the same town and range, may be recorded on this certificate.


1	A	B	C	D	E	F	G	H	I	J	K	L	M
2	6	5	4	3	2	1							
3													
4	7	8	9	10	11	12							
5													
6	18	17	16	15	14	13							
7													
8	19	20	21	22	23	24							
9													
10	30	29	28	27	26	25							
11													
12	31	32	33	34	35	36							
13													

A. Description of original monument and accessories and/or subsequent restoration:

- 1. G.L.O Original Survey:
 Township: 2nd Quarter 1837 John Hodgson Corner is common
 Pages 297, 298, 318 original field notes
- 2. County Survey Records:
 None of Record
- 3. L.C.R.C.:
 Liber 337, Page 79 John Sedgman 1979 Found 1/2" bar
 Liber 785, Page 95 Paul B. Lapham 1995 Found 1/2" re-rod
- 4. Surveys of Record:
 Liber 2, Page 405 John Sedgman 1978 Found 1/2" bar
- 5. Unrecorded Survey:
 Paul B. Lapham survey 1977 Found 1/2" bar
 Paul B. Lapham field notes 1978 Found 1/2" bar
 Paul B. Lapham survey 1982 Found 1/2" bar
 Paul B. Lapham survey 1982 Found 1/2" bar
 Paul B. Lapham survey 1988 Found 1/2" bar

APPROVED LAND CORNER
 P.A. 345 of 1990
 Clare County

Chairman Paul B. Lapham
 Date 9-13-00

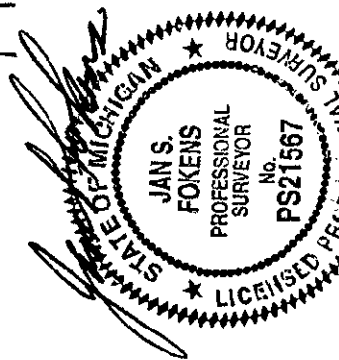

B. Description of corner evidence found and/or method applied in restoring or re-establishing corner:

- Established corner in Clare County Remonumentation Program. See dossier for detailed report.
- 1. Found 1/2" iron bent over another 1/2" iron to perpetuate its location
 - 2. Found 1/2" iron was lodged into a 1 1/4" pipe
 - 3. Pipe was guarded by 3 large stones. Wood fragments were found adjacent to pipe
 - 4. Excavated to 4', could not remove pipe.

Accepted as the best available evidence of the position of the original corner and replaced with Standard Monument Corner.

C. Description of monument for corner and accessories established to perpetuate locating the position of the corner:
 Corner common as established by GLO - Standard corner on township line (I-13 T.17N.-R.6W.). Set Standard Clare County Monument in Monument Box, stamped I-13/I-1 and PS 21567.

I-13 Corner common to sections 34 & 35, T.17N.-R.6W., Garfield Township, Clare Co., MI.

- S.66°W. 28.77' Top center of concrete R.O.W. marker
- S.45°E. 49.32' Found 60-D nail in South face of a power pole
- N.40°E. 55.58' Top center of concrete R.O.W. marker
- N.78°W. 20.71' North edge of North leg of road direction sign
- S.89°34'36"W 2653.37' H-13 S. 1/4 Corner, Section 34, T.17N.-R.6W., Garfield Twp., Clare Co., MI.
- S.89°26'51"E 2624.05' J-13 S. 1/4 Corner, Section 35, T.17N.-R.6W., Garfield Twp., Clare Co., MI.

Signed by Jan S. Fokens Date 12/12/00
 Surveyor's Michigan License No. 21567