

SURVEY & REMONUMENTATION

JAN 23 2001

SECTION LAND CORNER RECORDATION CERTIFICATE
Filing Requirement of Act 74, Mich. P.A. 1970
Clare County Remonumentation

For Corners in
Clare

(County)

Located In: Corner Code#:

- | | | |
|---------------------------------------|----------------------------|-------------|
| 1. Public Land Survey | T. <u>17N</u> R. <u>6W</u> | <u>J-13</u> |
| | T. _____ R. _____ | _____ |
| | T. _____ R. _____ | _____ |
| 2. Public Controlling in Section | S. _____ T. _____ R. _____ | _____ |
| | S. _____ T. _____ R. _____ | _____ |
| 3. Miscellaneous Property in Section | S. _____ T. _____ R. _____ | _____ |
| | S. _____ T. _____ R. _____ | _____ |
| 4. Lot No. _____, Recorded Plat _____ | | |
| 5. Private Claims _____ | | |

200000010155
 Filed for Record in
 CLARE COUNTY MICHIGAN
 CAROL MCAULAY
 On 12-15-2000 At 07:44 am.
 LAND CORNER 9.00
 OR Liber 2 Page 278 - 278

Instrument Liber Page
 200000010155 OR 2 278

#483-00

Register of Deeds Stamp & File Number

I, Jan S. Fokens, in a field survey on March 6, 2000, do hereby certify that under requirements of P.A. 74, Michigan P.A. of 1970, the corner points mentioned in lines 1 and 2 above were in conformance with regulations and rules therefore as required in the current manual of survey instructions of the United States Department of the Interior, Bureau of Land Management or by a decree of a Court of Law and/or that the corner points mentioned in lines 3, 4 and 5 above were in conformance with the rules of the Michigan Board of Land Surveyors or by a Decree of a Court of Law, established, re-established, monumened, re-monumented, recovered, found as expressed below.

NOTE: Not more than 2 corners, all in the same town and range, may be recorded on this certificate.

	A	B	C	D	E	F	G	H	I	J	K	L	M
2	6	5	4	3	2	1							
3													
4	7	8	9	10	11	12							
5													
6	18	17	16	15	14	13							
7													
8	19	20	21	22	23	24							
9													
10	30	29	28	27	26	25							
11													
12	31	32	33	34	35	36							
13													

A. Description of original monument and accessories and/or subsequent restoration: -

- G.L.O Original Survey:
 Township: 2nd Quarter 1837 John Hodgson
 Pages 297 original field notes
- County Survey Records:
 None of Record
- L.C.R.C.:
 Liber 432, Page 83 Paul Lapham 1983 Found 3/4" square bar
- Surveys of Record:
 None of Record
- Unrecorded Survey:
 Paul B. Lapham & Assoc. Survey 1982 Found 1" pipe
 Paul B. Lapham & Assoc. Survey 1989 Found 3/4" square bar

APPROVED LAND CORNER
 P.A. 345 of 1990
 Clare County

Chairman Paul B. Lapham
 Date 9-13-00

B. Description of corner evidence found and/or method applied in restoring or re-establishing corner:


Existent corner established in Clare County Remonumentation Program. See dossier for detailed report.

- Found 1 1/4" pipe
- Excavated to 2.5'. Found no further evidence.

Accepted as the best available evidence of the position of the original corner and replaced with Standard Monument Corner.

C. Description of monument for corner and accessories established to perpetuate locating the position of the corner:
 Set Standard Clare County Monument in Monument Box, stamped J-13/17-6 and J-1/16-6 and PS 21567.

- J-13 S. 1/4 Corner, Section 35, T.17N.-R.6W., Garfield Township, Clare Co., MI.**
- S.18° W. 34.62' Found nail and cap in West face of power pole
 - S.10°E. 36.30' Top center of 1' concrete post
 - N.05°W. 37.78' Found nail and cap in E. face of power pole
 - East 2.90' Capped iron #21567, Property controlling corner
 - S.89°31'54"E. 2624.31' K-13, corner common to sections 35 and 36, T.17N.-R.6W., Garfield Twp., Clare Co., MI.
 - N.89°26'51"W. 2624.05' I-13, corner common to sections 34 & 35, T.17N.-R.6W., Garfield Twp., Clare Co., MI.

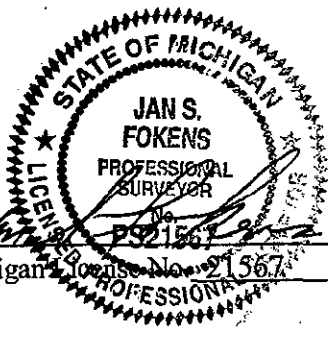

Signed by Jan S. Fokens
 Surveyor's Michigan License No. PS21567

Date 12/12/00