

**LAND CORNER RECORDATION CERTIFICATE**  
**Filing Requirement of Act 74, Mich. P.A. 1970**

For corners in

<u>CLARE</u> (County)	Located In:	Corner Code #
1. Public Land Survey	T <u>17N</u> R <u>6W</u>	<u>K-7</u>
	T ___ R ___	_____
	T ___ R ___	_____
	T ___ R ___	_____
2. Property Controlling in Section	S ___ T ___ R ___	_____
	S ___ T ___ R ___	_____
3. Miscellaneous Property in Sec.	S ___ T ___ R ___	_____
	S ___ T ___ R ___	_____

RECEIVED  
 E M  
 #152-96  
 96 NOV 14 PM 4:15  
 REGISTER OF DEEDS  
 CLARE COUNTY  
 DONNA M. CARR  
 Register of Deeds Stamp & File Number

4. Lot No. \_\_\_\_\_, Recorded Plat \_\_\_\_\_  
 5. Private Claims \_\_\_\_\_

I, MARK R. ROBISON, in a field survey on AUGUST, 1996 do hereby state that under requirements of P.A. 74, Michigan P.A. of 1970, the corner points mentioned in lines 1 and 2 above were in conformance with regulations and rules therefore as required in the current manual of survey instructions of the United States Department of the Interior, Bureau of Land Management or by a decree of a Court of Law and/or that the corner points mentioned in lines 3, 4 and 5 above were in conformance with the rules of the Michigan Board of Land Surveyors or by a Decree of a Court of Law; established, re-established, monumented, recovered, found as expressed below:

	A	B	C	D	E	F	G	H	I	J	K	L
1												
2	6		5		4		3		2		1	
3												
4	7		8		9		10		11		12	
5												
6	18		17		16		15		14		13	
7												
8	19		20		21		22		23		24	
9												
10	30		29		28		27		26		25	
11												
12	31		32		33		34		35		36	
13												

NOTE: Not more than 2 corners, all in the same town and range, may be recorded on this certificate.

A. Description of original monument and accessories and/or subsequent restoration:

1847 LYON WIT.-PINE 10" S74 1/2°W 61 LKS. NORWAY PINE 9" N41 1/2°E 12 LKS.	5-4-92 LAPHAM, WIT.-FOUND MON. 3.62' N. OF CENTERLINE SAME WITNESSES AS L.C.R.C. #405
9-18-81 LAPHAM, L.C.R.C. #405 WIT.-FOUND MON. BOX. S45°W, 82.15' - FENCE COR. N45°W, 79.45' - FENCE COR. S30°E, 54.07' - STOP SIGN POST.	9-25-89 LAPHAM, P.B. LAPHAM & ASSOC. FILES WIT.-SAME WITNESSES AS L.C.R.C. #405 MEAS. EAST 2636.50' TO S 1/4 COR. MDOT R/W FILE 18-R-3 SHEET 34 INDICATES SECTION CORNER LOCATION.

B. Description of corner evidence found and/or method applied in restoring or reestablishing corner:

FOUND 3/4" IRON IN MON. BOX.  
 MEAS. EAST, 2636.78' TO L-7.  
 MEAS. WEST, 2617.88' TO J-7.


C. Description of monument for corner and accessories established to perpetuate locating the position of the corner:

SET 5/8"x36" RE-ROD WITH 3" CLARE COUNTY MONUMENT CAP IN MONUMENT BOX.  
 ACCEPTED AS BEST AVAILABLE EVIDENCE OF THE ACCEPTED POSITION OF THE CORNER.

WITNESSES:  
 S40°E, 86.64' - NAIL & TAG IN POWER POLE.  
 N38°E, 87.15' - NAIL & TAG IN POWER POLE.  
 S45°W, 82.15' - NAIL & TAG IN FENCE COR. (OBT).  
 N45°W, 79.45' - NAIL & TAG IN FENCE COR. (OBT).

APPROVED LAND CORNER  
 P.A. 345 of 1990  
 Clare County  
 Chairman Paul S. [Signature]  
 Date 11-07-96

Signed by Mark R. Robison  
 Surveyor's Michigan License No. 27458

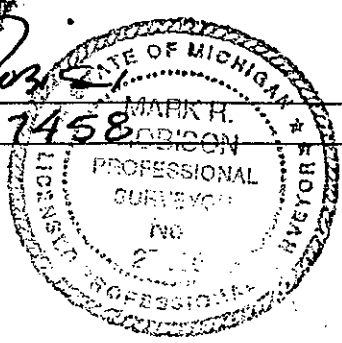

Date 9-23-96