

**SURVEY &
REMONUMENTATION**

JAN 23 2001

SECTION

**LAND CORNER RECORDATION CERTIFICATE
Filing Requirement of Act 74, Mich. P.A. 1970
Clare County Remonumentation**

For Corners in
Clare

(County)

Located In:

Corner Code#:

- 1. Public Land Survey T. 17N R. 6W K-13
 T. _____ R. _____
 T. _____ R. _____
- 2. Public Controlling S. _____ T. _____ R. _____
 in Section S. _____ T. _____ R. _____
- 3. Miscellaneous S. _____ T. _____ R. _____
 Property in Section S. _____ T. _____ R. _____
- 4. Lot No. _____, Recorded Plat _____
- 5. Private Claims _____

200000010156
 Filed for Record in
 CLARE COUNTY MICHIGAN
 CAROL MCAULAY
 On 12-15-2000 At 07:44 am.
 LAND CORNER 9.00
 OR Liber 2 Page 279 - 279

Instrument Liber Page
 200000010156 OR 2 279

#484-00

Register of Deeds Stamp & File Number

I, Jan S. Fokens, in a field survey on February 1, 2000, do hereby certify that under requirements of P.A. 74, Michigan P.A. of 1970, the corner points mentioned in lines 1 and 2 above were in conformance with regulations and rules therefore as required in the current manual of survey instructions of the United States Department of the Interior, Bureau of Land Management or by a decree of a Court of Law and/or that the corner points mentioned in lines 3, 4 and 5 above were in conformance with the rules of the Michigan Board of Land Surveyors or by a Decree of a Court of Law, established, re-established, monumented, re-monumented, recovered, found as expressed below.

NOTE: Not more than 2 corners, all in the same town and range, may be recorded on this certificate.

	A	B	C	D	E	F	G	H	I	J	K	L	M
1													
2	6	5	4	3	2	1							
3													
4	7	8	9	10	11	12							
5													
6	18	17	16	15	14	13							
7													
8	19	20	21	22	23	24							
9													
10	30	29	28	27	26	25							
11													
12	31	32	33	34	35	36							
13													

A. Description of original monument and accessories and/or subsequent restoration: -

- 1. G.L.O Original Survey:
 Township: 2nd Quarter 1837 John Hodgson
 Pages 297, 312 original field notes
- 2. County Survey Records:
 None of Record
- 3. L.C.R.C.:
 Liber 142, Page 74 Paul Lapham 1972 Found 1/2" re-rod
 Liber 590, Page 89 Paul Lapham 1989 Set re-rod per LCRC #142-74
- 4. Surveys of Record:
 Liber 1, Page 94 L. Urbaniak 1972 Distances noted
 Liber 1, Page 405 Paul B. Lapham & Assoc. 1989 Found 1/2" capped iron
- 5. Unrecorded Survey:
 Paul B. Lapham & Assoc. Survey 1972 Distances noted
 Paul B. Lapham & Assoc. Survey 1974 Found 1/2" re-rod

APPROVED LAND CORNER
 P.A. 345 of 1990
 Clare County
 Chairman Paul S. Lapham
 Date 9-13-00

B. Description of corner evidence found and/or method applied in restoring or re-establishing corner:

Existent corner established in Clare County Remonumentation Program. See dossier for detailed report.

- 1. Found 1/2" capped iron
- 2. Excavated to 2.5'. Found no further evidence

Accepted as the best available evidence of the position of the original corner and replaced with Standard Monument Corner.

C. Description of monument for corner and accessories established to perpetuate locating the position of the corner:


Corner common as established by GLO - Standard corner on township line (K-13 T.17N.-R.6W.). Set Standard Clare County Monument in Monument Box, stamped K-13/17-6 and K-1/16-6 and PS 21567.

K-13 Corner common to sections 35 and 36, T.17N.-R.6W., Garfield Township, Clare Co., MI.

- N.56°W. 50.29' Set nail and tag in South face of 6" Cherry tree
- S.83°E. 33.63' Set nail and tag in North face of stub pole
- S.30°E. 48.13' Found PK nail in East face of power pole
- S.51°W. 45.80' Found PK in top center of 1' x 1' concrete pillar
- N.89°31'54"W. 2624.31' 1/4 Corner, Section 35, T.17N.-R.6W., Garfield Twp., Clare Co., MI.
- S.89°55'26"E. 2507.77' 1/4 Corner, Section 36, T.17N.-R.6W., Garfield Twp., Clare Co., MI.

Signed by

Surveyor's Michigan

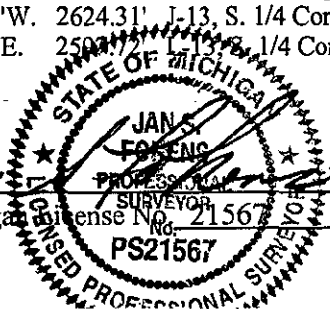

Date

12/12/00