

**SURVEY &  
REMONUMENTATION**

JAN 23 2001

**LAND CORNER RECORDATION CERTIFICATE**  
Filing Requirement of Act 74, Mich. P.A. 1970  
Clare County Remonumentation

SECTION

For Corners in  
Clare

|   |                            |               |
|---|----------------------------|---------------|
| (County)                                | Located In:                | Corner Code#: |
| 1. Public Land Survey                   | T. <u>17N</u> R. <u>6W</u> | <u>L-13</u>   |
|   | T. _____ R. _____          | _____         |
|   | T. _____ R. _____          | _____         |
| 2. Public Controlling<br>in Section     | S. _____ T. _____ R. _____ | _____         |
|   | S. _____ T. _____ R. _____ | _____         |
| 3. Miscellaneous<br>Property in Section | S. _____ T. _____ R. _____ | _____         |
|   | S. _____ T. _____ R. _____ | _____         |
| 4. Lot No. _____, Recorded Plat _____   |                            |               |
| 5. Private Claims _____                 |                            |               |

200000010157  
Filed for Record in  
CLARE COUNTY MICHIGAN  
CAROL MCAULAY  
On 12-15-2000 At 07:44 am.  
LAND CORNER 9.00  
OR Liber 2 Page 280 - 280

Instrument Liber Page  
200000010157 OR 2 280

# 485-00

Register of Deeds Stamp & File Number

I, Jan S. Fokens, in a field survey on February 1, 2000, do hereby certify that under requirements of P.A. 74, Michigan P.A. of 1970, the corner points mentioned in lines 1 and 2 above were in conformance with regulations and rules therefore as required in the current manual of survey instructions of the United States Department of the Interior, Bureau of Land Management or by a decree of a Court of Law and/or that the corner points mentioned in lines 3, 4 and 5 above were in conformance with the rules of the Michigan Board of Land Surveyors or by a Decree of a Court of Law, established, re-established, monumented, re-monumented, recovered, found as expressed below.

NOTE: Not more than 2 corners, all in the same town and range, may be recorded on this certificate.

|    |    |    |    |    |    |    |   |   |   |   |   |   |   |
|----|----|----|----|----|----|----|---|---|---|---|---|---|---|
| 1  | A  | B  | C  | D  | E  | F  | G | H | I | J | K | L | M |
| 2  | 6  | 5  | 4  | 3  | 2  | 1  |   |   |   |   |   |   |   |
| 3  |    |    |    |    |    |    |   |   |   |   |   |   |   |
| 4  | 7  | 8  | 9  | 10 | 11 | 12 |   |   |   |   |   |   |   |
| 5  |    |    |    |    |    |    |   |   |   |   |   |   |   |
| 6  | 18 | 17 | 16 | 15 | 14 | 13 |   |   |   |   |   |   |   |
| 7  |    |    |    |    |    |    |   |   |   |   |   |   |   |
| 8  | 19 | 20 | 21 | 22 | 23 | 24 |   |   |   |   |   |   |   |
| 9  |    |    |    |    |    |    |   |   |   |   |   |   |   |
| 10 | 30 | 29 | 28 | 27 | 26 | 25 |   |   |   |   |   |   |   |
| 11 |    |    |    |    |    |    |   |   |   |   |   |   |   |
| 12 | 31 | 32 | 33 | 34 | 35 | 36 |   |   |   |   |   |   |   |
| 13 |    |    |    |    |    |    |   |   |   |   |   |   |   |

A. Description of original monument and accessories and/or subsequent restoration:

- G.L.O Original Survey:  
Township: 2<sup>nd</sup> Quarter 1837 John Hodgson  
Pages 297 original field notes
- County Survey Records:  
None of Record
- L.C.R.C.:  
None of Record
- Surveys of Record:  
Liber 1, Page 94-100 (page 3) L. Urbaniak 1972 Distances noted
- Unrecorded Survey:  
None available

APPROVED LAND CORNER  
P.A. 345 of 1990  
Clare County

Chairman *Paul S. Fokens*  
Date 9-13-00

B. Description of corner evidence found and/or method applied in restoring or re-establishing corner:


- Existent corner established in Clare County Remonumentation Program. See dossier for detailed report.
- Found 1/2" re-bar surrounded by guard stones.
  - Excavated to 3'. Found no further evidence.

Accepted as the best available evidence of the position of the original corner and replaced with Standard Monument Corner.

C. Description of monument for corner and accessories established to perpetuate locating the position of the corner:

Set Standard Clare County Monument in Monument Box, stamped L-13/17-6 and L-1/16-6 and PS 21567.

|               |  |  |
|---------------|--|--|
| L-13          | S. 1/4 Corner, Section 36, T.17N.-R.6W., Garfield Township, Clare Co., MI. |  |
| N.62°W.       | 20.20'   | Found nail and flagging in north face oak (twin 18's)                                |
| N.74°E.       | 60.95'   | Found nail and flagging in north face of twin 30" Maple.                             |
| S.09°W.       | 16.05'   | Found nail and flagging in west face of 30" Oak.                                     |
| East          | 26.06'   | Set nail and tag in north face of 6" Maple.  |
| S.89°53'57"E. | 2641.22'   | M-13 Corner common to four townships (corner deep in swamp)                          |
| N.88°55'26"W. | 2597.72'   | K-13, Corner common to sections 35 & 36, T.17N.-R.6W., Garfield Twp., Clare Co., MI. |

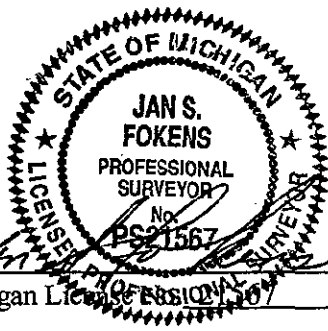

Signed by *Jan S. Fokens* Date 12/12/00  
Surveyor's Michigan License No. PS 21567