

LAND CORNER RECORDATION CERTIFICATE
 Filing Requirement of Act 74, Mich. P.A. 1970

For corners in

| | | |
|---------------------------------------|--------------------------|---------------|
| <u>CLARE</u> (County) | Located In: | Corner Code # |
| 1. Public Land Survey | T <u>17N</u> R <u>3W</u> | <u>B-5</u> |
| | T _____ R _____ | _____ |
| | T _____ R _____ | _____ |
| | T _____ R _____ | _____ |
| 2. Property Controlling in Section | S _____ T _____ R _____ | _____ |
| | S _____ T _____ R _____ | _____ |
| 3. Miscellaneous Property in Sec. | S _____ T _____ R _____ | _____ |
| | S _____ T _____ R _____ | _____ |

REGISTER OF DEEDS
 CLARE COUNTY
 DONNA M. GARR
 95 NOV 14 PM 4:17
 #166-96
 E IV 1

Register of Deeds Stamp & File Number

4. Lot No. _____, Recorded Plat _____
 5. Private Claims _____

I, MARK R. ROBISON, in a field survey on AUGUST, 1996 do hereby state that under requirements of P.A. 74, Michigan P.A. of 1970, the corner points mentioned in lines 1 and 2 above were in conformance with regulations and rules therefore as required in the current manual of survey instructions of the United States Department of the Interior, Bureau of Land Management or by a decree of a Court of Law and/or that the corner points mentioned in lines 3, 4 and 5 above were in conformance with the rules of the Michigan Board of Land Surveyors or by a Decree of a Court of Law; established, re-established, monumented, recovered, found as expressed below:

NOTE: Not more than 2 corners, all in the same town and range, may be recorded on this certificate.

| | | | | | | | | | | | |
|----|----|---|----|---|----|---|----|---|----|---|----|
| A | B | C | D | E | F | G | H | I | J | K | L |
| 1 | | | | | | | | | | | |
| 2 | 6 | | 5 | | 4 | | 3 | | 2 | | 1 |
| 3 | | | | | | | | | | | |
| 4 | 7 | | 8 | | 9 | | 10 | | 11 | | 12 |
| 5 | ● | | | | | | | | | | |
| 6 | 18 | | 17 | | 16 | | 15 | | 14 | | 13 |
| 7 | | | | | | | | | | | |
| 8 | 19 | | 20 | | 21 | | 22 | | 23 | | 24 |
| 9 | | | | | | | | | | | |
| 10 | 30 | | 29 | | 28 | | 27 | | 26 | | 25 |
| 11 | | | | | | | | | | | |
| 12 | 31 | | 32 | | 33 | | 34 | | 35 | | 36 |
| 13 | | | | | | | | | | | |

A. Description of original monument and accessories and/or subsequent restoration:
 1850 BURT 05-02-90 WILCOX L.C.R.C. PLANS
 WIT.-SET 1/4 SEC. POST WIT.-FOUND 1/2" IRON.
 S81°E 38 LKS, 8" IRONWOOD S01°E, 70.05' TW. 48" COTTONWOOD.
 N75°E, 42 LKS. PINE S47°E, 87.48' - N.E. COR. BRICK BLDG.
 UNDATED, C.S.R. L.5, PG. 7 S25°E, 61.09' - N.W. COR. BRICK BLDG.
 WIT.-B-3 TO B-5 79.50' 2659.29' EAST TO C-5

6-23-80 FLUHARTY, (132) L.2, PG. 626
 WIT.-FOUND 5/8" IRON.
 SOUTH, 32.46' - POWER POLE.
 S30°E, 61.65' - N.W. COR. BLK. GARAGE.
 N35°W, 98.47' - S.E. COR. HSE. FD. N.
 MEAS. W. 3011.59' TO A-5.

B. Description of corner evidence found and/or method applied in restoring or reestablishing corner:

FOUND 1/2"x18" CAPPED IRON (J.L.W.) IN MON. BOX.
 CHECKED 1980 & 1990 WITNESSES.

See dossier for detailed report.


C. Description of monument for corner and accessories established to perpetuate locating the position of the corner:

SET 5/8"x36" RE-ROD WITH 3" CLARE COUNTY MONUMENT CAP.
 ACCEPTED AS BEST AVAILABLE EVIDENCE OF THE ACCEPTED POSITION OF THE CORNER.

WITNESSES:
 SOUTH, 32.46' - NAIL & TAG IN POWER POLE.
 S38°W, 61.57' - N.W. COR. BLK. GARAGE (OBT).
 N29°W, 98.47' - S.E. COR. FOUNDATION (OBT).
 NORTH 84.74' - NAIL & TAG IN 12" ELM.

APPROVED LAND CORNER
 P.A. 345 of 1990
 Clare County
 Chairman [Signature]
 Date 11-2-96

Signed by Mark R. Robison
 Surveyor's Michigan License No. 27458

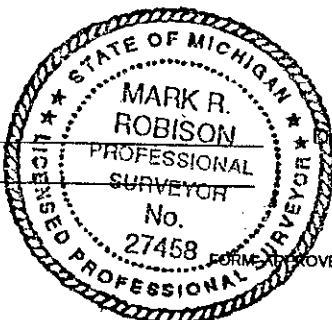

Date 10-1-96