

**SURVEY & REMONUMENTATION**

JAN 23 2001

SECTION

**LAND CORNER RECORDATION CERTIFICATE**  
**Filing Requirement of Act 74, Mich. P.A. 1970**  
**Clare County Remonumentation**

For Corners in  
Clare

(County)

Located In:

Corner Code#:

- 1. Public Land Survey T. 17N R. 3W B-7  
 T. \_\_\_\_\_ R. \_\_\_\_\_  
 T. \_\_\_\_\_ R. \_\_\_\_\_
- 2. Public Controlling S. \_\_\_\_\_ T. \_\_\_\_\_ R. \_\_\_\_\_  
 in Section S. \_\_\_\_\_ T. \_\_\_\_\_ R. \_\_\_\_\_
- 3. Miscellaneous S. \_\_\_\_\_ T. \_\_\_\_\_ R. \_\_\_\_\_  
 Property in Section S. \_\_\_\_\_ T. \_\_\_\_\_ R. \_\_\_\_\_
- 4. Lot No. \_\_\_\_\_, Recorded Plat \_\_\_\_\_
- 5. Private Claims \_\_\_\_\_

20000009290  
 Filed for Record in  
 CLARE COUNTY MICHIGAN  
 CAROL MCAULAY  
 On 11-14-2000 At 11:04 am.  
 LAND CORNER 9.00  
 OR Liber 2 Page 216 - 216

Instrument Liber Page  
 20000009290 OR 2 216

#421-00

Register of Deeds Stamp & File Number

I, Mark R. Robison, in a field survey on March 13, 2000, do hereby certify that under requirements of P.A. 74, Michigan P.A. of 1970, the corner points mentioned in lines 1 and 2 above were in conformance with regulations and rules therefore as required in the current manual of survey instructions of the United States Department of the Interior, Bureau of Land Management or by a decree of a Court of Law and/or that the corner points mentioned in lines 3, 4 and 5 above were in conformance with the rules of the Michigan Board of Land Surveyors or by a Decree of a Court of Law, established, re-established, monumented, re-monumented, recovered, found as expressed below.

**NOTE: Not more than 2 corners, all in the same town and range, may be recorded on this certificate.**

	A	B	C	D	E	F	G	H	I	J	K	L	M
2	6	5	4	3	2	1							
3													
4	7	8	9	10	11	12							
5													
6	18	17	16	15	14	13							
7													
8	19	20	21	22	23	24							
9													
10	30	29	28	27	26	25							
11													
12	31	32	33	34	35	36							
13													

A. Description of original monument and accessories and/or subsequent restoration:

GLO  
 Burt, 1850  
 B. Ash 24" N3°E, 14 LINKS  
 B. Ash 8" N27°W, 28 LINKS

Survey, Lapham, 1978 L2. Pg. 371  
 Set capped rerod, 4 witnesses

C.S.R.  
 Johnson, 1912, Bk. 2. Pg. 20  
 Tele. Pole 8" N75° 30' West 89 LINKS  
 Gas Pipe 4' long and stake

Survey, Robison, 1989 L3. Pg. 192  
 Fd iron, same 4 witnesses as 2-371

Lapham, 1978 LCRC #319-78  
 Set capped rerod by SPM, same 4 witnesses as 2-371

C.S.R.  
 No Surveyor, Circa, 1900 Bk. 5 Pg. 19  
 Tele. Pole 8" N75° 30' West 89 LINKS  
 Gas Pipe 4' long and stake  
 N70°W, 93 LINKS

B. Description of corner evidence found and/or method applied in restoring or re-establishing corner:


No GLO evidence or CSR evidence. Found Lapham capped iron and 3 witnesses. Found 3/4" x 24" solid rod in 3/4" x 15" pipe total 30"/long lying 5.39' SW of capped iron at 0.67' South of section line. Excavated to 3' deep at both irons nothing else found. Occupation line north of 3/4" rod, fence line South 3' West of 3/4" rod, East 1/8 line fence indicates point 2' East of capped iron, and West 1/8 line occupation indicates point 2' West of capped iron. No history on 3/4" rod. Treated as lost corner after review of fences and occupation resulted in inconclusive evidence. Accepted found capped iron as best available evidence of the accepted position of the corner.

C. Description of monument for corner and accessories established to perpetuate locating the position of the corner:  
 Set 5/8" x 36" rerod with Clare County Remon Cap marked P.S. #27458.

Witnesses:  
 N03°W, 51.55' - Power Pole  
 S20°W, 34.30' - Fence Corner (OBT)  
 S30°W, 43.60' - 15" Box Elder (OBT)  
 S61°W, 83.40' - 20" Box Elder (OBT)

Signed by Mark R. Robison  
 Surveyor's Michigan License No. 27458

Date 11-15-2000

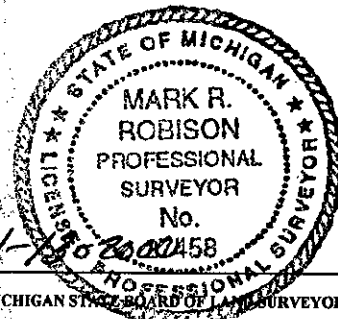

FORM APPROVED BY MICHIGAN STATE BOARD OF LAND SURVEYORS, JAN. 28, 1971

REVISED MAY 14, 1975  
 REVISED JAN., 1983