

SURVEY & REMONUMENTATION

JAN 23 2001

LAND CORNER RECORDATION CERTIFICATE

Filing Requirement of Act 74, Mich. P.A. 1970

Clare County Remonumentation

SECTION

200000010144
 Filed for Record in
 CLARE COUNTY MICHIGAN
 CAROL MCAULAY
 On 12-15-2000 At 07:44 am.
 LAND CORNER 9.00
 OR Liber 2 Page 267 - 267

For Corners in

<u>Clare</u> (County)	Located In:	Corner Code#:
1. Public Land Survey	T. <u>17N</u> R. <u>3W</u>	<u>D-7</u>
	T. _____ R. _____	_____
	T. _____ R. _____	_____
2. Public Controlling in Section	S. _____ T. _____ R. _____	_____
	S. _____ T. _____ R. _____	_____
3. Miscellaneous Property in Section	S. _____ T. _____ R. _____	_____
	S. _____ T. _____ R. _____	_____
4. Lot No. _____, Recorded Plat _____		
5. Private Claims		

Instrument Liber Page
 200000010144 OR 2 267

#472-00

Register of Deeds Stamp & File Number

I, Mark R. Robison, in a field survey on March 15, 2000, do hereby certify that under requirements of P.A. 74, Michigan P.A. of 1970, the corner points mentioned in lines 1 and 2 above were in conformance with regulations and rules therefore as required in the current manual of survey instructions of the United States Department of the Interior, Bureau of Land Management or by a decree of a Court of Law and/or that the corner points mentioned in lines 3, 4 and 5 above were in conformance with the rules of the Michigan Board of Land Surveyors or by a Decree of a Court of Law, established, re-established, monumented, re-monumented, recovered, found as expressed below.

	A	B	C	D	E	F	G	H	I	J	K	L	M
1													
2	6	5	4	3	2	1							
3													
4	7	8	9	10	11	12							
5													
6	18	17	16	15	14	13							
7													
8	19	20	21	22	23	24							
9													
10	30	29	28	27	26	25							
11													
12	31	32	33	34	35	36							
13													

NOTE: Not more than 2 corners, all in the same town and range, may be recorded on this certificate.

A. Description of original monument and accessories and/or subsequent restoration:

G.L.O Burt, 1850 Sugar 10" S82°E, 21 LINKS Beech 6" N72°W, 11 LINKS	C.S.R., Bk. 5. Pg. 20 Maple 12" N39°W Apple Tree 4" N35 1/2°, 52 LINKS Pine Stump 18" S30°W, 53 LINKS
--	--

APPROVED LAND CORNER.
 P.A. 345 of 1990
 Clare County
 Chairman Paul S. Leph
 Date 5-10-00

B. Description of corner evidence found and/or method applied in restoring or re-establishing corner:

Found 3/4" x 1/2" x 18" Bar Excavated to 3' Found plow point in broken crockery and pile of stones	Measured: D-7 to C-7 2637.04 D-7 to E-7 2643.56 D-7 to occupation (tree line South) West 25' (+-)
--	--


Accepted found iron as best available evidence of accepted position of the corner.

C. Description of monument for corner and accessories established to perpetuate locating the position of the corner:

Set 5/8" x 36" re-rod with Clare County Remon Cap marked P.S #27458.

Witnesses:

N55°W, 51.47' - Cen. Tele Riser
 South, 28.75' - N & T in 10" Elm
 S45°W, 44.72' - N & T in Cor. Fence Post
 S58°E, 67.75' - N & T in 10" Poplar

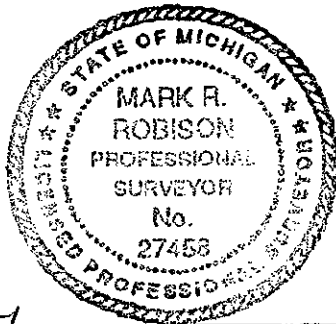

Signed by Mark R. Robison
 Surveyor's Michigan License No. 27458

Date 12/19/2000