

LAND CORNER RECORDATION CERTIFICATE
Filing Requirement of Act 74, Mich. P.A. 1970

For corners in

<u>CLARE</u> (County)	Located In:	Corner Code #	
1. Public Land Survey	T <u>17N</u> R <u>3W</u>	E-5	
	T <u> </u> R <u> </u>		
	T <u> </u> R <u> </u>		
	T <u> </u> R <u> </u>		
2. Property Controlling in Section	S <u> </u> T <u> </u> R <u> </u>		
	S <u> </u> T <u> </u> R <u> </u>		
3. Miscellaneous Property in Sec.	S <u> </u> T <u> </u> R <u> </u>		
	S <u> </u> T <u> </u> R <u> </u>		

RECEIVED
#164-96
95 OCT 14 PM 4:17
REGISTER OF DEEDS
CLARE COUNTY
DOUGLAS M. CARR

Register of Deeds Stamp & File Number

4. Lot No. _____, Recorded Plat _____
5. Private Claims _____

I, MARK R. ROBISON, in a field survey on AUGUST, 1996 do hereby state that under requirements of P.A. 74, Michigan P.A. of 1970, the corner points mentioned in lines 1 and 2 above were in conformance with regulations and rules therefore as required in the current manual of survey instructions of the United States Department of the Interior, Bureau of Land Management or by a decree of a Court of Law and/or that the corner points mentioned in lines 3, 4 and 5 above were in conformance with the rules of the Michigan Board of Land Surveyors or by a Decree of a Court of Law, established, re-established, monumented, recovered, found as expressed below:

NOTE: Not more than 2 corners, all in the same town and range, may be recorded on this certificate.

A	B	C	D	E	F	G	H	I	J	K	L	M
1												
2	6		5		4		3		2		1	
3												
4	7		8		9		10		11		12	
5												
6	18		17		16		15		14		13	
7												
8	19		20		21		22		23		24	
9												
10	30		29		28		27		26		25	
11												
12	31		32		33		34		35		36	
13												

A. Description of original monument and accessories and/or subsequent restoration:

1850 BURT WIT.-SET POST BEECH 8" N82°E 17 LKS. BEECH 6" S88°W 16 LKS.	NO DATE C.S.R. L.5, PG.16 WIT.-TELE. POLE 8" S 4 1/2"W 54 LKS. E-5 TO G-5 79.72 CH. E-5 TO E-7 80.20 CH.	2-14-78 LAPHAM, (132) L.2, PG. 379 WIT.-SAME AS 7-27-73
4-24-07 JOHNSON, C.S.R. L.4, PG. 101 WIT.-TELEGRAPH POLE S41 1/2"W 54 LKS. E-5 TO G-5 79.72 CH. SEC. CORS. FOUND BUT NO 1/4 CORS. FOUND.	7-27-73 URBANIAK, (132) L.1, PG. 538 WIT.-FOUND "T" IRON. N50°W, 43.65' - 14" ASH S53°W, 53.66' - TELE. POLE. S45°W, 43.97' - COR. FENCE POST. MEAS. S. 5294.15' TO E-7.	1993 WILCOX, CO. ROAD PLANS WIT.-FOUND 1/2" IRON. MEAS. W. 2647.01' TO D-5. S16°E, 81.20' - 13" ELM. N24°E, 72.25' - 8" ELM. N43°W, 43.54' - 24" ASH. S30°W, 57.83' - 6" ELM.

11-6-73 LAPHAM, L.C.R.C. #116
WIT.-SAME AS 7-27-73

B. Description of corner evidence found and/or method applied in restoring or reestablishing corner:

FOUND CAPPED IRON (JLW) IN MON. BOX AT INTER. C'S MEASURED SOUTH 5294.04' TO E-7. DID NOT FIND ANY OLD WITNESSES (REMOVED BY CONSTRUCTION)

See dossier for detailed report.

C. Description of monument for corner and accessories established to perpetuate locating the position of the corner:


SET 5/8"x36" RE-ROD WITH 3" CLARE COUNTY MONUMENT CAP IN MONUMENT BOX.
ACCEPTED AS BEST AVAILABLE EVIDENCE OF THE ACCEPTED POSITION OF THE CORNER.

WITNESSES:
N55°W, 130.52' - S.E. COR. BRICK MILKING PARLOR.
N24°E, 144.66' - NAIL & TAG IN POWER POLE.
S13°E, 198.92' - NAIL & TAG IN POWER POLE.
S55°W, 47.18' - N.E. COR. CONC. BASE ELEC. BOX.

APPROVED LAND CORNER
P.A. 345 of 1990
Clare County

Chairman Paul B. Goffe
Date 11-07-96

Signed by Mark R. Robison
Surveyor's Michigan License No. 27458

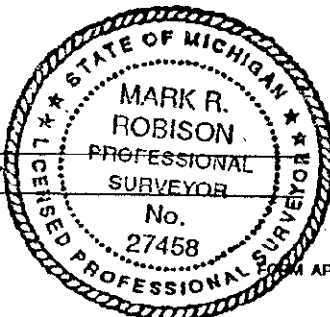

Date 10-1-96