

LAND CORNER RECORDATION CERTIFICATE
Filing Requirement of Act 74, Mich. P.A. 1970

For corners in

<u>CLARE</u> (County)	Located In:	Corner Code #
1. Public Land Survey	<u>T17N R 3W</u>	<u>G-5</u>
	T <u> </u> R <u> </u>	<u> </u>
	T <u> </u> R <u> </u>	<u> </u>
	T <u> </u> R <u> </u>	<u> </u>
2. Property Controlling in Section	S <u> </u> T <u> </u> R <u> </u>	<u> </u>
	S <u> </u> T <u> </u> R <u> </u>	<u> </u>
3. Miscellaneous Property in Sec.	S <u> </u> T <u> </u> R <u> </u>	<u> </u>
	S <u> </u> T <u> </u> R <u> </u>	<u> </u>

E.V.
 #162-96
 96 NOV 14 PM 4
 REGISTER OF DEEDS
 CLARE COUNTY
 DONNA M. CARI
 Register of Deeds Stamp & File Number

4. Lot No. _____, Recorded Plat _____
5. Private Claims _____

I, MARK R. ROBISON, in a field survey on AUGUST, 1996 do hereby state that under requirements of P.A. 74, Michigan P.A. of 1970, the corner points mentioned in lines 1 and 2 above were in conformance with regulations and rules therefore as required in the current manual of survey instructions of the United States Department of the Interior, Bureau of Land Management or by a decree of a Court of Law and for that the corner points mentioned in lines 3, 4 and 5 above were in conformance with the rules of the Michigan Board of Land Surveyors or by a Decree of a Court of Law, established, re-established, monumented, recovered, found as expressed below:

NOTE: Not more than 2 corners, all in the same town and range, may be recorded on this certificate.

A	B	C	D	E	F	G	H	I	J	K	L	M
1												
2	6	5	4	3	2	1						
3												
4	7	8	9	10	11	12						
5												
6	18	17	16	15	14	13						
7												
8	19	20	21	22	23	24						
9												
10	30	29	28	27	26	25						
11												
12	31	32	33	34	35	36						
13												

A. Description of original monument and accessories and/or subsequent restoration:

- | | | |
|--|--|---|
| 1850 BURT,
WIT.-BEECH 15" N75°E 13 LKS.
BEECH 17" S22°E 18 LKS. | UNDATED, C.S.R. L.5, PG. 10
WIT.-G-5 TO G-3 79.84 1/2
BIRCH 15" N75°E 13 LKS.
BIRCH 17" S22°E 18 LKS. | 11-29-89 LAPHAM, L.C.R.C. #585
WIT.-FOUND 3" PIPE
S45°W, 75.0' - POWER POLE.
S45°E, 44.70' - TELE. RISER.
N45°E, 42.60' - TELE. RISER. |
| 4-18-07 JOHNSON, C.S.R. L.4, PG. 100
WIT.-FENCE POST 6" N45°E 61 LKS.
FENCE POST 8" S43°15'E 57 LKS. | UNDATED, C.S.R. L.5, PG. 15
WIT.-G-5 TO G-7 80.16' | 6-22-95 WETHERELL, (132) L.3, PG. 506
WIT.-FOUND IRON IN TILE.
N63°E, 42.87' - POWER POLE (STUB).
S36°E, 39.88' - FENCE POST.
S51°W, 95.05' - POWER POLE. |
| 4-24-07 JOHNSON, C.S.R. L.4, PG. 101
WIT.-E-5 TO G-5 79.72'
ALL SECTION CORNERS FOUND
BUT NO 1/4 CORNERS. | UNDATED C.S.R. L.5, PG. 16
WIT.-G-5 TO G-7 79.70'
G-5 TO E-5 79.72'
G-5 TO G-7 80.17' | |
| | 8-10-05
WIT.-G-5 TO G-3 79.84 1/2 | |

B. Description of corner evidence found and/or method applied in restoring or reestablishing corner:

FOUND 1/2"x18" CAPPED IRON OVER 3" TILE & IRON 1 1/2 FEET DEEP. FOUND THREE OLD WITNESSES.

See dossier for detailed report.


C. Description of monument for corner and accessories established to perpetuate locating the position of the corner:

SET 5/8"x36" RE-ROD WITH 3" CLARE COUNTY MONUMENT CAP.
ACCEPTED AS BEST AVAILABLE EVIDENCE OF THE ACCEPTED POSITION OF THE CORNER.

- WITNESSES:
 N33°W, 103.74' - S.W. CORNER BRICK HOUSE.
 N39°E, 42.76' - NAIL & TAG IN TELE. STUB RISER (OBT).
 S48°W, 75.02' - NAIL & TAG IN POWER POLE (OBT).
 S29°E, 44.84' - CENTER TELE. BOX (OBT).

APPROVED LAND CORNER
 P.A. 345 of 1990
 Clare County
 Chairman Paul B. Lapham
 Date 11-27-96

Signed by Mark R. Robison
 Surveyor's Michigan License No. 27458

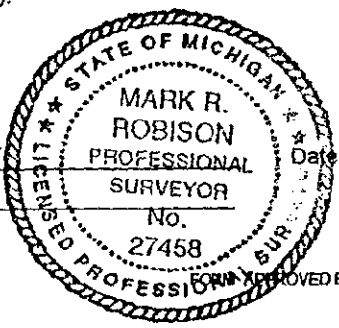

Date 10-1-96