

**SURVEY &
REMONUMENTATION**

JAN 14 1999

Clare County Remonumentation

SECTION

LAND CORNER RECORDATION CERTIFICATE
Filing Requirement of Act 74, Mich. P.A. 1970

For corners in

_____ Clare _____ (County)	Located in:	Corner Code #
1. Public Land Survey	T17N R03W	L-5
	T _____ R _____	_____
	T _____ R _____	_____
	T _____ R _____	_____
2. Property Controlling in Section	S _____ T _____ R _____	_____
	S _____ T _____ R _____	_____
3. Miscellaneous Property in Sec.	S _____ T _____ R _____	_____
	S _____ T _____ R _____	_____

RECEIVED
326-98
98 DEC 29 PM 3:05
REGISTER OF DEEDS
CLARE COUNTY
CAROL A. McAULAY

Register of Deeds Stamp & File Number

4. Lot No. _____, Recorded Plat _____
5. Private Claims _____

I, Mark R Robison, in a field survey on August, 1998 do hereby state that under requirements of P.A. 74, Michigan P.A. of 1970, the corner points mention in lines 1 and 2 above were in conformance with regulations and rules therefore as required in the current manual of survey instructions of the United States Department of the Interior, Bureau of Land Management or by a decree of a Court of Law and/or that the corner points mentioned in lines 3, 4 and 5 above were in conformance with the rules of the Michigan Board of Land Surveyors or by a Decree of a Court of Law; established, re-established, monumented, recovered, found as expressed below:

A	B	C	D	E	F	G	H	I	J	K	L	M
1												
2	6	5	4	3	2	1						
3												
4	7	8	9	10	11	12						
5												
6	18	17	16	15	14	13						
7												
8	19	20	21	22	23	24						
9												
10	30	29	28	27	26	25						
11												
12	31	32	33	34	35	36						
13												

NOTE: Not more than 2 corners, all in the same town and range, may be recorded on this certificate

A. Description of original monument and accessories and/or subsequent restoration:

- L-5: 1850 BURT
WIT. -B. ASH 6" N46°W 5 LKS
B. ASH 6" S38°E 18 LKS.
- UNDATED, C.S.R. L.5, PG. 13
WIT. -OAK 4" N37°W 44 1/2 LKS.
L- TO L-7, 79.56 & M-5
TO K-5, 80.30
- 5-18-01 HARPER, C.S.R. L. 1, PG. 7
WIT. -STAKE, IRON AND CROCKERY IN HIGHWAY
AT EQUAL DISTANCE.
K-5 TO M-5, 79.96
- 5-22-75 MEYERS (132) L.1, PG. 998
WIT. -SET 1/2" CAPPED RE-REOD.
S50°W, 53.00' - COR. F. POST.
N15°W, 33.75' - FENCE POST.
S50°W, 111.08' - POWER POLE.
- 8-20-75 LAPHAM, L.C.R.C. #206
WIT. -SAME AS 5-22-75
- 10-30-89 ROBINSON, P.B.L. & ASSOC. FILES INCLUDING SKETCH OF SECTION 12.
WIT. -FOUND CAPPED IRON.
S50°W, 110.74' - POWER POLE.
N20°W, 33.73' -COR. FENCE.
N45°W, 42.4' - TWIN 15 ELM.
N20°E, 39.8' - 8" W. OAK.
- 11-29-89 LAPHAM, L.C.R.C. #587
WIT. -SAME AS 10-31-89

B. Description of corner evidence found and/or method applied in restoring or reestablishing corner:


L-5: FOUND 1/2" X18" CAPPED IRON. FOUND 4-1989 WITNESSES AND FOUND 2-1975 WITNESSES, MEASURED WEST 2646.48' TO K-5. (1989 SURVEY INDICATES, 2646.64 WEST TO K-5 & 2645.97 EAST TO M-5)

SEE DOSSIER FOR DETAILED REPORT.

C. Description of monument for corner and accessories established to perpetuate locating the position of the corner:

L-5: SET 5/8"X36" RE-ROD WITH 3" CLARE COUNTY MONUMENT CAP. MARKED PS.27418 IN MON. BOX. ACCEPTED AS BEST AVAILABLE EVIDENCE OF THE ACCEPTED POSITION OF THE CORNER.

- WITNESSES:
- S63°W, 110.96' - NAIL & TAG IN POWER POLE (OBT).
 - N20°W, 33.73' - NAIL & TAG IN COR. FENCE POST (OBT).
 - N43°W, 42.40' - NAIL & TAG IN TWIN 18" ELM (OBT).
 - N40°E, 39.80' - NAIL & TAG IN 12" W. OAK. (OBT).
 - N17°E, 45.32' - NAIL & TAG IN 10" OAK.

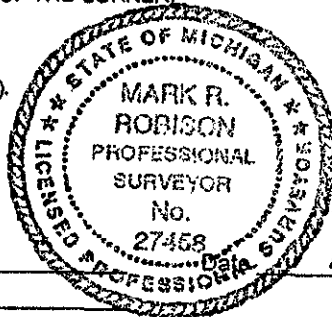

APPROVED LAND CORNER
P.A. 345 of 1990
Clare County
Chairman Paul B. Popham
Date 12-08-98

Signed by Mark R. Robison
Surveyor's Michigan License No. 27458

Date 12-28-98