

LAND CORNER RECORDATION CERTIFICATE
Filing Requirement of Act 74, Mich. P.A. 1970

For corners in

CLARE
(County)

Located In:

Corner Code #

1. Public Land Survey

T 17N R 3W M-5

2. Property Controlling in Section

S _____ T _____ R _____

3. Miscellaneous Property in Sec.

S _____ T _____ R _____

4. Lot No. _____, Recorded Plat _____
5. Private Claims _____

RECORDED
E 11
#161-96
SO NOV 14 PM 4:17
REGISTER OF DEEDS
CLARE COUNTY
DONNE M. CARR
Register of Deeds Stamp & File Number

I, MARK R. ROBISON, in a field survey on AUGUST, 19 96 do hereby state that under requirements of P.A. 74, Michigan P.A. of 1970, the corner points mentioned in lines 1 and 2 above were in conformance with regulations and rules therefore as required in the current manual of survey instructions of the United States Department of the Interior, Bureau of Land Management or by a decree of a Court of Law and /or that the corner points mentioned in lines 3, 4 and 5 above were in conformance with the rules of the Michigan Board of Land Surveyors or by a Decree of a Court of Law; established, re-established, monumented, recovered, found as expressed below:

NOTE: Not more than 2 corners, all in the same town and range, may be recorded on this certificate.

	A	B	C	D	E	F	G	H	I	J	K	L	M
1													
2	6		5		4		3		2		1		
3													
4	7		8		9		10		11		12		
5													
6	18		17		16		15		14		13		
7													
8	19		20		21		22		23		24		
9													
10	30		29		28		27		26		25		
11													
12	31		32		33		34		35		36		
13													

A. Description of original monument and accessories and/or subsequent restoration:

1837 HODGSON
WIT.-SET POST
HEMLOCK 20" N54°W 45 LKS.
BLACK ASH 16" S27°W 20 LKS.

5-22-75 MEYERS, (132) L.I, PG. 998
WIT.-FOUND 5/8" BAR, RAISED WITH
1/2" CAPPED RE-ROD.
S25°E, 43.20' - 14" MAPLE.
S05°W, 31.28' - TELE. POLE.
N30°W, 55.75' - TELE. POLE.

UNDATED, UNKNOWN C.S.R. L.5, PG. 13
WIT.-M-5 TO K-5, 80.30'

5-28-01 HARPER, C.S.R. L.1, PG. 7
WIT.-ROUND CEDAR STAKES AND CROCKERY.
HEMLOCK 20" N54°W 45 LKS.
B. ASH 16" S27°W 20 LKS.
M-5 TO K-5, 79.96'

8-20-75 LAPHAM, L.C.R.C. #206
WIT.-SAME AS 5-22-75

B. Description of corner evidence found and/or method applied in restoring or reestablishing corner:

FOUND 1/2"x18" IRON OVER 5/8" BAR. FOUND TWO 1975 WITNESSES.

See dossier for detailed report.

C. Description of monument for corner and accessories established to perpetuate locating the position of the corner:


SET 5/8"x36' RE-ROD WITH 3" CLARE COUNTY MONUMENT CAP IN MONUMENT BOX.
ACCEPTED AS BEST AVAILABLE EVIDENCE OF THE ACCEPTED POSITION OF THE CORNER.

WITNESSES:
S05°W, 31.28' - NAIL & TAG IN TELE. POLE (OBT).
N28°W, 55.75' - NAIL & TAG IN TELE POLE (OBT).
N60°E, 47.30' - NAIL & TAG IN COR. FENCE POST.
N79°W, 95.25' - NAIL & TAG IN 15" ASH.

APPROVED LAND CORNER
P.A. 345 of 1990
Clare County

Chairman Donald D. Saylor
Date 11-07-96

Signed by Mark R. Robison
Surveyor's Michigan License No. 27458

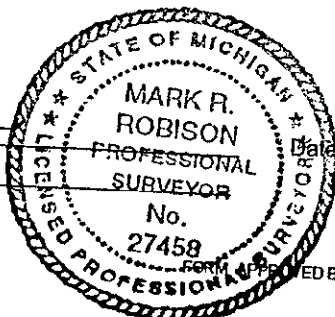

10-1-96