

**SURVEY &
REMONUMENTATION**

JAN 17 1996

COMMISSION

LAND CORNER RECORDATION CERTIFICATE
Filing Requirement of Act 74, Mich. P.A. 1970

RECEIVED
#126-95
95 DEC 15 PM 3:37
REGISTER OF DEEDS
CLARE COUNTY
DORIS M. CARR

For corners in

CLARE (County)	Located In:	Corner Code #
1. Public Land Survey	T <u>17NR</u> 4W	<u>A-5</u>
	T ___ R ___	___
	T ___ R ___	___
	T ___ R ___	___
2. Property Controlling in Section.	S ___ T ___ R ___	___
	S ___ T ___ R ___	___
3. Miscellaneous Property in Sec.	S ___ T ___ R ___	___
	S ___ T ___ R ___	___

Register of Deeds Stamp & File Number

4. Lot No. _____, Recorded Plat _____
5. Private Claims _____

I, MARK R. ROBISON, in a field survey on NOVEMBER 19 95 do hereby state that under requirements of P.A. 74, Michigan P.A. of 1970, the corner points mentioned in lines 1 and 2 above were in conformance with regulations and rules therefore as required in the current manual of survey instructions of the United States Department of the Interior, Bureau of Land Management or by a decree of a Court of Law and /or that the corner points mentioned in lines 3, 4 and 5 above were in conformance with the rules of the Michigan Board of Land Surveyors or by a Decree of a Court of Law; established, re-established, monumented, recovered, found as expressed below:

	A	B	C	D	E	F	G	H	I	J	K	L	M
1													
2	6			5			4		3			2	1
3													
4	7			8			9		10			11	12
5													
6	18			17			16		15			14	13
7													
8	19			20			21		22			23	24
9													
10	30			29			28		27			26	25
11													
12	31			32			33		34			35	36
13													

NOTE: Not more than 2 corners, all in the same town and range, may be recorded on this certificate.

A. Description of original monument and accessories and/or subsequent restoration:

1837 JOHN HUDSON
WIT.-BIRCH 12" S14°W 28
BIRCH 12" N46°W 39

1959 DNR
FOUND IRON & TILE
SET 4"x42" MON.
WIT.-S25°W 18.35' 8" IRONWOOD
N66°W 68.00' 10" ELM
S25°E 45.7' 9" BASSWOOD

5-81 PAUL LAPHAM
4" PIPE FILLED WITH CONC. & CONSV. DEPT. CAP
WIT.-S20°E 19.0' 8" BASSWOOD
S16°W 56.61' 7" BASSWOOD
S44°W 18.57' 8" HOP HORNBEAN

1910 JOHNSON
A-5 GRANT
WIT.-W.PINE 20 GOV'T S43°E 29
N. PINE 30 S87°W 44

MSHD RESURVEY
US.10 FOUND 4" PIPE, CONS. DEPT. SURVEY
WIT.-S20°E 19.0' 8" BASSWOOD
S16°W 56.61' 7" BASSWOOD
S44°W 18.57' 8" HOP HORNBEAN

9-81 PAUL LAPHAM L.C.R.C. 402-81
SAME AS ABOVE
WIT.-S20°E 19.0' 8" BASSWOOD
S16°W 56.61' 7" BASSWOOD
S44°W 18.57' 8" HOP HORNBEAN

NO DATE, NO SURVEYOR
WIT.-W. PINE STUMP 18 N & E 29
W. PINE STUMP 24 S & W 44

B. Description of corner evidence found and/or method applied in restoring or reestablishing corner:

FOUND 4" DIA. PIPE FILLED WITH CONCRETE SET IN CONCRETE BASE WITH CONSERVATION DEPT. CAP.
WITNESSES HAVE BEEN DESTROYED.

APPROVED LAND CORNER
P.A. 345 of 1990
Clare County
Chairman Paul L. Lapham
Date 12-12-95


This Corner established in Clare County Remonumentation Program.

See dossier for detailed report.

C. Description of monument for corner and accessories established to perpetuate locating the position of the corner:

A-5: 7-18 SECTION CORNER ON TOWNSHIP LINE
FOUND 4" DIAMETER PIPE FILLED WITH CONCRETE AND CAPPED WITH CONSERVATION DEPT. BRASS CAP.
ACCEPTED AS BEST AVAILABLE EVIDENCE OF THE ACCEPTED POSITION OF THE CORNER.

WITNESSES:
N52°E 18.06' - NAIL & TAG IN 4" WHITE OAK.
S10°E 19.0; - NAIL & TAG IN 10" HOP HORNBEAN.
S37 1/2°W 71.90' - NAIL & TAG IN 12" TWIN HOP HORNBEAN.
S04°W 62.46' - NAIL & TAG IN 8" HOP HORNBEAN.

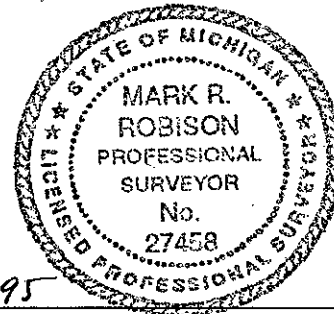

Signed by Mark R. Robison
Surveyor's Michigan License No. 27458

Date 12-13-95