

**SURVEY &
REMONUMENTATION**

JAN 17 1996

COMMISSION

LAND CORNER RECORDATION CERTIFICATE
Filing Requirement of Act 74, Mich. P.A. 1970

For corners in

<u>CLARE</u> (County)	Located In:	Corner Code #
1. Public Land Survey	T <u>17</u> NR <u>4W</u>	<u>A-6</u>
	T ___ R ___	_____
	T ___ R ___	_____
	T ___ R ___	_____
2. Property Controlling in Section	S ___ T ___ R ___	_____
	S ___ T ___ R ___	_____
3. Miscellaneous Property in Sec.	S ___ T ___ R ___	_____
	S ___ T ___ R ___	_____

RECEIVED
 REGISTERED DEEDS
 CLARE COUNTY
 DONNA M. CARR
 95 DEC 15 PM 3:27
 # 12-5-95

Register of Deeds Stamp & File Number

4. Lot No. _____, Recorded Plat _____
 5. Private Claims _____

I, MARK R. ROBISON, in a field survey on NOVEMBER 19 95 do hereby state that under requirements of P.A. 74, Michigan P.A. of 1970, the corner points mentioned in lines 1 and 2 above were in conformance with regulations and rules therefore as required in the current manual of survey instructions of the United States Department of the Interior, Bureau of Land Management or by a decree of a Court of Law and /or that the corner points mentioned in lines 3, 4 and 5 above were in conformance with the rules of the Michigan Board of Land Surveyors or by a Decree of a Court of Law; established, re-established, monumented, recovered, found as expressed below:

A	B	C	D	E	F	G	H	I	J	K	L	M
1												
2	6		5		4		3		2		1	
3												
4	7		8		9		10		11		12	
5												
6	18		17		16		15		14		13	
7												
8	19		20		21		22		23		24	
9												
10	30		29		28		27		26		25	
11												
12	31		32		33		34		35		36	
13												

NOTE: Not more than 2 corners, all in the same town and range, may be recorded on this certificate.

A. Description of original monument and accessories and/or subsequent restoration:

1837 JOHN HUDSON
 18" CEDAR AT CORNER

 NO DATE NO SURVEYOR
 TYLE & CINDERS, CEDAR STUMP 12 N81°W 26
 M.S.H.D. FOUND 4" TILE OVER 3" TILE & CINDERS
 SET 3/8" ROD

 2-72 PAUL LAPHAM (132 SURVEY)
 NO WITNESSES

B. Description of corner evidence found and/or method applied in restoring or reestablishing corner:

FOUND 3/8"x30" IRON IN 4" CLAY TILE. REPLACED IRON WITH 5/8"x36" IRON, LEFT THE CLAY TILE.
 FOUND M.S.H.D. WITNESSES.

APPROVED LAND CORNER
 P.A. 345 of 1990
 Clare County

Chairman Paul H. Tappin

Date 12-12-95


This Corner established in Clare County Remonumentation Program.

See dossier for detailed report.

C. Description of monument for corner and accessories established to perpetuate locating the position of the corner:

A-6: WEST 1/4 CORNER, SECTION 18
 SET 5/8"x36" RE-ROD WITH 3" CLARE COUNTY MONUMENT CAP IN OLD 4" CLAY TILE.
 ACCEPTED AS BEST AVAILABLE EVIDENCE OF THE PERPETUATION OF THE C.S.R. CORNER.

WITNESSES:
 S87°E 29.97' - NAIL & TAG IN 10" CEDAR (OBT)
 N68°E 37.54' - NAIL & TAG IN 8" CEDAR (OBT)
 WEST 28.30' - NAIL & TAG IN 8" CEDAR
 S40°E 34.30' - NAIL & TAG IN 12" ELM

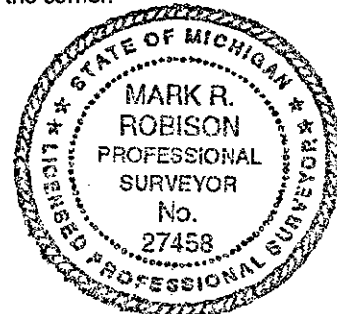

Signed by Mark R. Robison

Date 12-13-95

Surveyor's Michigan License No. 27458