

**SURVEY &
REMONUMENTATION**

JAN 17 1996

COMMISSION LAND CORNER RECORDATION CERTIFICATE
Filing Requirement of Act 74, Mich. P.A. 1970

For corners in

<u>CLARE</u> (County)	Located In:	Corner Code #	
1. Public Land Survey	T <u>17N</u> R <u>4W</u>	<u>A-8</u>	
	T ___ R ___	_____	
	T ___ R ___	_____	
	T ___ R ___	_____	
2. Property Controlling in Section	S ___ T ___ R ___	_____	
	S ___ T ___ R ___	_____	
3. Miscellaneous Property in Sec.	S ___ T ___ R ___	_____	
	S ___ T ___ R ___	_____	

RECEIVED
#123-95-A-10
95 DEC 15 PM 3:27
REGISTER OF DEEDS
CLARE COUNTY
DUNN MARR

Register of Deeds Stamp & File Number

4. Lot No. _____, Recorded Plat _____
5. Private Claims _____

I, MARK R. ROBISON, in a field survey on OCTOBER, 19 95 do hereby state that under requirements of P.A. 74, Michigan P.A. of 1970, the corner points mentioned in lines 1 and 2 above were in conformance with regulations and rules therefore as required in the current manual of survey instructions of the United States Department of the Interior, Bureau of Land Management or by a decree of a Court of Law and /or that the corner points mentioned in lines 3, 4 and 5 above were in conformance with the rules of the Michigan Board of Land Surveyors or by a Decree of a Court of Law; established, re-established, monumented, recovered, found as expressed below:

NOTE: Not more than 2 corners, all in the same town and range, may be recorded on this certificate.

1	A	B	C	D	E	F	G	H	I	J	K	L	M
2		6		5		4		3		2		1	
3													
4		7		8		9		10		11		12	
5													
6		18		17		16		15		14		13	
7													
8		19		20		21		22		23		24	
9													
10		30		29		28		27		26		25	
11													
12		31		32		33		34		35		36	
13													

A. Description of original monument and accessories and/or subsequent restoration:

1837 JOHN HUDSON
WIT.-HEMLOCK 7" S59°W 9
HEMLOCK 7" N65°W 11

10-91 MARK ROBISON
FOUND IRON, SET CAPPED IRON
WIT.-N40°E 59.0' 5" POPLAR
N45°W 29.39' 2nd POST FENCE NORTH
WEST 25.97' END POST FENCE SOUTH
S30°W 41.0' 4th POST FENCE SOUTH

NO DATE OR SURVEYOR (C.S.R.)
WIT.-W.P. STUMP 18, N25°E 48 1/2
W.P. STUMP 16, N72°E 46

6-21-73 URBANIAK (132) SURVEY
FOUND TILE IN FENCE CORNER (FIELD NOTES)

9-5-74 MCCLUNG PLAT OF THE MEADOW, RECORDED PLAT

B. Description of corner evidence found and/or method applied in restoring or reestablishing corner:

FOUND TILE IN FENCE CORNER 26' WEST OF CORNER REC. IN 10-91 L.C.R.C.
FOUND & REMOVED C.I. #21781 ± 0.5' E OF TILE. CORNER REC IN 10-91 L.C.R.C. IS IN ERROR AND IRON WAS REMOVED.

APPROVED LAND CORNER
P.A. 345 of 1990

Clare County

Chairman Paul B. Leph

Date 12-12-95


This Corner established in Clare County Remonumentation Program.

See dossier for detailed report.

C. Description of monument for corner and accessories established to perpetuate locating the position of the corner:

A-8: WEST 1/4 CORNER, SECTION 19
SET 5/8"x36" RE-ROD WITH 3" CLARE COUNTY MONUMENT IN 3" TILE.
ACCEPTED AS BEST AVAILABLE EVIDENCE OF THE PERPETUATION OF THE C.S.R. CORNER.

WITNESSES:
EAST 33.6' CAPPED IRON #21781
N45°E 3.55' FOUND SPIKE IN 24" CHERRY
N50°W 52.00' - NAIL & TAG IN 17" OAK
SOUTH 68.50' - NAIL & TAG IN 15" CHERRY

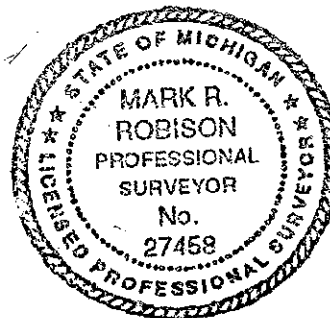

Signed by Mark R. Robison
Surveyor's Michigan License No. 27458

Date 12-13-95