

**SURVEY & REMONUMENTATION**

**JAN 23 2001**

**SECTION**

**LAND CORNER RECORDATION CERTIFICATE**  
**Filing Requirement of Act 74, Mich. P.A. 1970**  
**Clare County Remonumentation**

For Corners in  
Clare

(County)

Located In:

Corner Code#:

- 1. Public Land Survey T. 17N R. 4W C-13  
 T. \_\_\_\_\_ R. \_\_\_\_\_  
 T. \_\_\_\_\_ R. \_\_\_\_\_
- 2. Public Controlling S. \_\_\_\_\_ T. \_\_\_\_\_ R. \_\_\_\_\_  
 in Section S. \_\_\_\_\_ T. \_\_\_\_\_ R. \_\_\_\_\_
- 3. Miscellaneous S. \_\_\_\_\_ T. \_\_\_\_\_ R. \_\_\_\_\_  
 Property in Section S. \_\_\_\_\_ T. \_\_\_\_\_ R. \_\_\_\_\_
- 4. Lot No. \_\_\_\_\_, Recorded Plat \_\_\_\_\_
- 5. Private Claims \_\_\_\_\_

200000009696  
 Filed for Record in  
 CLARE COUNTY MICHIGAN  
 CAROL MCAULAY  
 On 11-29-2000 At 10:31 am.  
 LAND CORNER 9.00  
 OR Liber 2 Page 226 - 226

Instrument Liber Page  
 200000009696 OR 2 226

*#431-00*

**Register of Deeds Stamp & File Number**

I, Mark R. Robison, in a field survey on November 17, 2000, do hereby certify that under requirements of P.A. 74, Michigan P.A. of 1970, the corner points mentioned in lines 1 and 2 above were in conformance with regulations and rules therefore as required in the current manual of survey instructions of the United States Department of the Interior, Bureau of Land Management or by a decree of a Court of Law and/or that the corner points mentioned in lines 3, 4 and 5 above were in conformance with the rules of the Michigan Board of Land Surveyors or by a Decree of a Court of Law, established, re-established, monumented, re-monumented, recovered, found as expressed below.

	A	B	C	D	E	F	G	H	I	J	K	L	M
2	6	5	4	3	2	1							
3													
4	7	8	9	10	11	12							
5													
6	18	17	16	15	14	13							
7													
8	19	20	21	22	23	24							
9													
10	30	29	28	27	26	25							
11													
12	31	32	33	34	35	36							
13													

**NOTE: Not more than 2 corners, all in the same town and range, may be recorded on this certificate.**

A. Description of original monument and accessories and/or subsequent restoration:

GLO, Hodgson, 1837  
 Black Ash 13" N28°W, 18 LINKS  
 Black Ash 10" N70°E, 11 LINKS

GLO, Isabella Co., Burt, 1850  
 Corner falls 37 Links East of Standard Corner

C.S.R., Unknown, 1899, Bk. 5 Pg. 175 & 176  
 C-13 to B-13 = 40.00 chains  
 C-13 to A-13 = 84.00 chains  
 C-13 to E-13 = 79.56 chains

C.S.R., Johnson, 1903, Bk. 4 Pg. 17  
 Stake in center of road  
 C-13 to D-13 = 40.10 chains  
 C-13 to E-13 = 80.20 chains

Lapham, 1974, LCRC #168-74  
 Found 1/2" bar, 3 witnesses

Survey, Lapham, 1974, L1. Pg. 859  
 Same as LCRC #168-74  
 C-13 to B-13 = 2664.00  
 C-13 to A-13 = 5586.37

Survey, Meyers, 1972 Closing Corner  
 3 witnesses

Survey, Lapham, 1977 Closing Corner  
 Found 5/8" rered. Same witnesses as  
 1972 Meyers survey

Survey, P. Lapham, 1979, Closing Corner  
 Found sucker rod, same 3 witnesses  
 as 1972 Meyers survey

Survey, T. Lapham, 1982 Closing Corner  
 Same as 1979 P. Lapham survey

Survey, Robison, 1990 Closing Corner  
 Same as 1979 P. Lapham survey

Survey, Robison, 1998 Closing Corner  
 Found 1/2" rod, 4 witnesses with 2  
 the same as 1979 P. Lapham survey

**APPROVED LAND CORNER**  
**P.A. 345 of 1990**  
**Clare County**

Chairman *Paul Lapham*  
 Date 9-06-00

B. Description of corner evidence found and/or method applied in restoring or re-establishing corner.

No GLO evidence found. Found 1/2" rod (standard corner) and 1/2" rod (closing corner) 27.94 East. (GLO falling = 24.42). Found 3 witnesses from 1974 LCRC. Distance to A-13 matches 1974 survey. Corner matches road location. Accepted found iron as best available evidence of accepted position of the corner.


C. Description of monument for corner and accessories established to perpetuate locating the position of the corner:

Set 5/8" x 36" rered with Clare County Remon Cap marked P.S. #27458.

Witnesses:

- N60°E, 52.87' - Found N & T in P.P. (OBT)
- S33°W, 28.82' - N & T in Fence Post 1<sup>st</sup> West of Corner Fence Post
- S50° 30' E, 81.85' - N & T new P.P.
- N68°W, 69.34' - N & T in P.P.
- East, 27.94' - 1/2" Rered

Signed by *Mark R. Robison*  
 Surveyor's Michigan License No. 27458

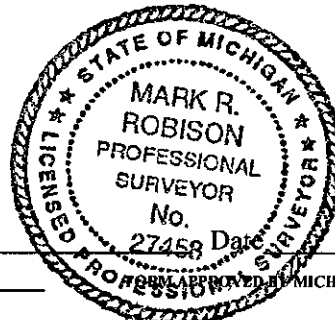

11-28-2000