

RECEIVED

#251-97
97 DEC 23 AM 10:06

CLARE COUNTY REMONUMENTATION

LAND CORNER RECORDATION CERTIFICATE
Filing Requirement of Act 74, Mich. P.A. 1970

REGISTER OF DEEDS
CLARE COUNTY
CAROL A. MAULAY

For corners in

CLARE

(County)

Located in:

Corner Code #

1. Public Land Survey	T 17N R 4W	E-8
	T R	
	T R	
	T R	
2. Property Controlling in Section	S T R	
	S T R	
3. Miscellaneous Property in Sec.	S T R	
	S T R	

Register of Deeds Stamp & File Number

4. Lot No. _____, Recorded Plat _____
5. Private Claims _____

I, MARK R. ROBISON, in a field survey on July 1, 1997 do hereby state that under requirements of P.A. 74, Michigan P.A. of 1970, the corner points mentioned in lines 1 and 2 above were in conformance with regulations and rules therefore as required in the current manual of survey instructions of the United States Department of the Interior, Bureau of Land Management or by a decree of a Court of Law and/or that the corner points mentioned in lines 3, 4 and 5 above were in conformance with the rules of the Michigan Board of Land Surveyors or by a Decree of a Court of Law; established, re-established, monumented, recovered, found as expressed below:

NOTE: Not more than 2 corners, all in the same town and range, may be recorded on this certificate.

A	B	C	D	E	F	G	H	I	J	K	L	M
1												
2	6	5	4	3	2	1						
3												
4	7	8	9	10	11	12						
5												
6	18	17	16	15	14	13						
7												
8	19	20	21	22	23	24						
9												
10	30	29	28	27	26	25						
11												
12	31	32	33	34	35	36						
13												

A. Description of original monument and accessories and/or subsequent restoration:

- 1850 Burt Set 1/4 Post Wit.-W. Pine 30" S15E 11 Maple 6" N25W 21
- 6-23-1894 Unknown CSR 5-171 Wit.-W. Pine 30" S15E 11 E-8 to D-8 = 39.91
- 4-28-00 Harper CSR 1-3 Gov't Corner Witnesses Good Wit.-Maple post with glass in hwy E-8 to E-7 = 39.44
- 4-23-04 Johnson CSR 1-30, 4-37 & 5-165
- Wit.-Cedar Stake S46 1/2 Cedar stump 24 -N- 71 1/2 E-8 to E-7 = 39.76
- 5-1-72 Lapham LCRC#25 Wit.-NE 24.5 Twin 4" Elm SE 57.5 P.P.
- SW 46.5 Fence Corner 4-4-73 Sedgman (132) 1-452 Fd 1/2" bar
- Wit.-N55E 40.05 T. Pole S45E 58.10 P.P.

- S45W 46.40 Cor. Fence Post
- 4-4-73 Sedgman (132) 1-450-Same(132) 1-452
- 4-4-73 Sedgman (132) 1-451-Same(132) 1-452
- 8-9-73 Sedgman(132) 1-554 - Ref. LCRC#25
- 6-29-90 Robison (132) 3-172 Fd 5/8" bar
- Wit.-N45E 32.37 6" Elm
- N45W 32.56 8" Elm
- S45E 58.60 P.P.
- S45W 31.85 End of Culvert
- 5-4-92 Lapham LCRC#661
- Wit.-same as (132) 3-172

B. Description of corner evidence found and/or method applied in restoring or reestablishing corner:

Found 1/2" x 18" iron in monument box 3.5 ft. North of C.L. Road. Found one 1972 witness and two 1973 witnesses and one 1990 witness.

See dossier for detailed report.

APPROVED LAND CORNER

P.A. 345 of 1990

Clare County

Chairman Paul B. Lepson


Date 11-07-97

C. Description of monument for corner and accessories established to perpetuate locating the position of the corner:

Set 5/8" x 36" rered with Clare County Remonumentation Cap marked P.S.#27458 in Monument Box. Accepted as best available evidence of the accepted position of the corner.

Witnesses:

- N31W 44.18', nail & tag, 5" Elm
- S48W 42.58', West end New 15" C.M.P.
- S29E 58.60', nail & tag, P.P. (OBT)
- N10E 39.20', Center Tele. Riser

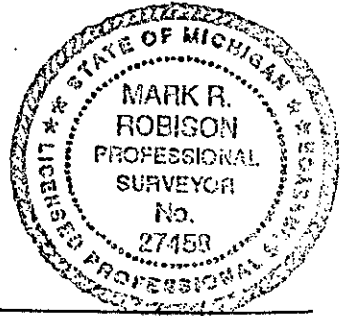

Signed by Mark R. Robison

Date 12-17-97

Surveyor's Michigan License No. 27458