

**SURVEY &
REMONUMENTATION**

JAN 23 2001

LAND CORNER RECORDATION CERTIFICATE

SECTION

Filing Requirement of Act 74, Mich. P.A. 1970

Clare County Remonumentation

For Corners in
Clare

(County)

Located In:

Corner Code#:

- 1. Public Land Survey T. 17N R. 4W G-13
T. _____ R. _____
T. _____ R. _____
- 2. Public Controlling S. _____ T. _____ R. _____
in Section S. _____ T. _____ R. _____
- 3. Miscellaneous S. _____ T. _____ R. _____
Property in Section S. _____ T. _____ R. _____
- 4. Lot No. _____, Recorded Plat _____
- 5. Private Claims _____

200000010145
Filed for Record in
CLARE COUNTY MICHIGAN
CAROL MCAULAY
On 12-15-2000 At 07:44 am.
LAND CORNER 9.00
OR Liber 2 Page 268 - 268

Instrument Liber Page
200000010145 OR 2 268

473-00

Register of Deeds Stamp & File Number

I, Mark R. Robison, in a field survey on May 9, 2000, do hereby certify that under requirements of P.A. 74, Michigan P.A. of 1970, the corner points mentioned in lines 1 and 2 above were in conformance with regulations and rules therefore as required in the current manual of survey instructions of the United States Department of the Interior, Bureau of Land Management or by a decree of a Court of Law and/or that the corner points mentioned in lines 3, 4 and 5 above were in conformance with the rules of the Michigan Board of Land Surveyors or by a Decree of a Court of Law, established, re-established, monumented, re-monumented, recovered, found as expressed below.

NOTE: Not more than 2 corners, all in the same town and range, may be recorded on this certificate.

	A	B	C	D	E	F	G	H	I	J	K	L	M
1													
2	6	5	4	3	2	1							
3													
4	7	8	9	10	11	12							
5													
6	18	17	16	15	14	13							
7													
8	19	20	21	22	23	24							
9													
10	30	29	28	27	26	25							
11													
12	31	32	33	34	35	36							
13													

A. Description of original monument and accessories and/or subsequent restoration:

- GLO, Hodgson, 1837
Beech 10" N44°E, 14 LINKS
Black Ash 18" N59°W, 39 LINKS
Survey, Lapham, 1980, Not recorded
Same as LCRC #207-75
- GLO, Burt, 1850
Closing corner falls 56 Links
East of standard corner
Survey, Lapham, 1988, L3. Pg. 68
Found 5/8" rod, same witnesses as #261-77
G-13 to F-13 = 2630.92
G-13 to 1/8 line fence = 1315.46
- Lapham, 1975, LCRC #207-75
Fd 3/8" Iron, 3 witnesses
Survey, Lapham, 1990, L3. Pg. 199
Same as survey L3. Pg. 68
G-13 to F-13 = 2630.92
- Fluharty, 1976, LCRC #261-77
Fd 3/4" Iron, 4 witnesses
LCRC, Isabella C. Robison, 1996 Closing Corner
Isabella Remon cap with 6 witnesses
Isabella Remonumentation L1 Pg. 144
- Survey, Lapham, 1980, Not recorded
Same as LCRC #207-75

APPROVED LAND CORNER
P.A. 345 of 1990
Clare County

Chairman Paul S. Leph
Date 9-06-00

B. Description of corner evidence found and/or method applied in restoring or re-establishing corner.


No GLO evidence found. Found 1 good witness from 1975 LCRC and 4 from LCRC #261-77. Measured falling 37.24 (GLO 36.96) East. Distance to 1/8 line fence West matches previous survey (1988). Distance to F-13 measures 9' more than 1988 survey. This is believed to be a mistake in previous survey. Accepted found iron as best available evidence of accepted position of the corner.

C. Description of monument for corner and accessories established to perpetuate locating the position of the corner:

Set 5/8" x 36" rered with Clare County Remon Cap marked P.S. #27458.

Witnesses:

- N61°E, 64.26' - N & T in P.P. (OBT)
- S50°E, 102.73' - N & T in 36" Oak Stump (OBT)
- South, 25.90' - Tele. Box (OBT)
- East, 37.12' - Isabella Remon Corner (OBT)

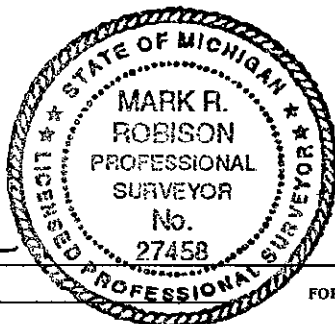

Signed by Mark R. Robison
Surveyor's Michigan License No. 27458

Date 12/14/2000