

LAND CORNER RECORDATION CERTIFICATE
Filing Requirement of Act 74, Mich. P.A. 1970

For corners in

<u>CLARE</u> (County)	Located In:	Corner Code #
1. Public Land Survey	T <u>17N</u> R <u>4W</u>	<u>K-7</u>
	T _____ R _____	_____
	T _____ R _____	_____
	T _____ R _____	_____
2. Property Controlling in Section	S _____ T _____ R _____	_____
	S _____ T _____ R _____	_____
3. Miscellaneous Property in Sec.	S _____ T _____ R _____	_____
	S _____ T _____ R _____	_____

FILED
 E V
 #173-96
 95 NOV 14 PM 4:18
 REGISTER OF DEEDS
 CLARE COUNTY
 DONNA H. GARR
 Register of Deeds Stamp & File Number

4. Lot No. _____, Recorded Plat _____
 5. Private Claims _____

I, MARK R. ROBISON, in a field survey on AUGUST, 1996 do hereby state that under requirements of P.A. 74, Michigan P.A. of 1970, the corner points mentioned in lines 1 and 2 above were in conformance with regulations and rules therefore as required in the current manual of survey instructions of the United States Department of the Interior, Bureau of Land Management or by a decree of a Court of Law and /or that the corner points mentioned in lines 3, 4 and 5 above were in conformance with the rules of the Michigan Board of Land Surveyors or by a Decree of a Court of Law; established, re-established, monumented, recovered, found as expressed below:

A	B	C	D	E	F	G	H	I	J	K	L	M
1												
2	6	5	4	3	2	1						
3												
4	7	8	9	10	11	12						
5												
6	19	17	16	15	14	13						
7												
8	19	20	21	22	23	24						
9												
10	30	29	28	27	26	25						
11												
12	31	32	33	34	35	36						
13												

NOTE: Not more than 2 corners, all in the same town and range, may be recorded on this certificate.

A. Description of original monument and accessories and/or subsequent restoration:

- | | | |
|--|---|--|
| 1850 BURT
WIT.-HEMLOCK 20" S43°W 14 LKS.
HEMLOCK 16" N20°E 25 LKS. | UNDATED C.S.R. L.5, PG. 158
C.S.R. L.5, PG. 167 | 10-19-71 LAPHAM, L.C.R.C. #19
WIT.- FOUND 1 1/2" PIPE
N40°E 45.10' POWER POLE
S17°E 74.60' TELE. POLE
S35°W 80.15' POWER POLE |
| 9-19-03 JOHNSON C.S.R. L.1, PG. 24.
WIT.-PINE STUMP 24" N22°W 76 LKS. | WIT.-PINE 24" N22°W 76 LKS.
K-7 TO I-7 IS 79.92' | |
| 9-19-03 JOHNSON C.S.R. L.4, PG. 29
WIT.-IRON STAKE
TELE. POLE 6", N48°W 53 LKS.
PINE STUMP 24", N22°W 76 LKS. | UNDATED C.S.R. L.5, PG. 168
WIT.-W. PINE STUMP 30", N25°W 60 LKS.
W. PINE STUMP 30", S25 1/2°E, 49 LKS.
W. PINE STUMP 30", N84 1/2°W, 66 LKS. | 6-7-74 RADCLIFFE L.C.R.C. #167
WIT.-FOUND 1 1/2" IRON PIPE.
N40°E 46.00' POWER POLE.
N55°W 87.96' TELE. POLE.
S40°W 80.10' POWER POLE. |
| 11-18-08 JOHNSON C.S.R. L.4, PG. 153
WIT.-SAME AS C.S.R. L.1, PG.24 | 7-3-71 LAPHAM, L.C.R.C. #3
WIT.-FOUND 1" PIPE
WIT.-S35°W, 80.15' - NAIL & TAG IN POWER POLE.
N45°W, 54.1' - NAIL & TAG IN COR. FENCE POST.
N40°E, 45.1' - NAIL & TAG IN POWER POLE. | 8-15-75 LAPHAM, L.C.R.C. #167 (132)
(132) L.2, PG. 17 |

B. Description of corner evidence found and/or method applied in restoring or reestablishing corner:

FOUND 1 1/2" PIPE SURROUNDED BY STONES 1 1/2 FEET BELOW ASPHALT. FOUND WITNESSES AS NOTED BELOW. COULD NOT REMOVE IRON. SET 5/8"x12" RE-ROD IN TOP OF PIPE. SET MON. BOX AND POURED ASPHALT TO BOTTOM OF CAP.

See dossier for detailed report.


C. Description of monument for corner and accessories established to perpetuate locating the position of the corner:

SET 5/8"x12" RE-ROD WITH 3" CLARE COUNTY MONUMENT CAP IN 1 1/2" PIPE IN MON. BOX FILLED WITH ASPHALT, ACCEPTED AS BEST AVAILABLE EVIDENCE OF PERPETUATION OF C.S.R. CORNER.

- WITNESSES:
 S43°W, 80.16' - NAIL & TAG IN TELE. POLE. (OBT)
 N46°W, 54.22' - NAIL & TAG IN COR. FENCE POST. (OBT)
 N40°E, 45.18' - NAIL & TAG IN POWER POLE. (OBT)
 S08°E, 125.70' - NAIL & TAG IN POWER POLE.

APPROVED LAND CORNER
 P.A. 345 of 1990
 Clare County
 Chairman Paul H. Lough
 Date 11-07-96

Signed by Mark R. Robison
 Surveyor's Michigan License No. 27458

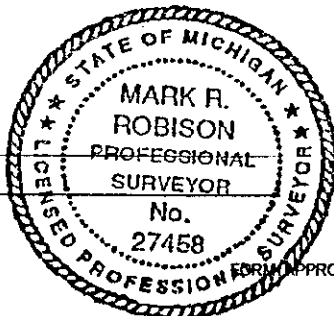

Date 10-1-96