

**LAND CORNER RECORDATION CERTIFICATE**  
**Filing Requirement of Act 74, Mich. P.A. 1970**

RECEIVED  
 E 10 A D  
 #88-95  
 95 OCT -3 PM 2:47  
 REGISTER OF DEEDS  
 CLARE COUNTY  
 DONNA M CARR

For corners in CLARE Located In: \_\_\_\_\_ Corner Code # \_\_\_\_\_  
 (County)

|                                      |   |            |   |           |            |
|--------------------------------------|---|------------|---|-----------|------------|
| 1. Public Land Survey                | T | <u>18N</u> | R | <u>3W</u> | <u>A-7</u> |
|                                      | T | _____      | R | _____     | _____      |
|                                      | T | _____      | R | _____     | _____      |
|                                      | T | _____      | R | _____     | _____      |
| 2. Property Controlling in Section   | S | _____      | T | _____     | _____      |
|                                      | S | _____      | T | _____     | _____      |
| 3. Miscellaneous Property in Section | S | _____      | T | _____     | _____      |
|                                      | S | _____      | T | _____     | _____      |

4. Lot No. \_\_\_\_\_, Recorded Plat \_\_\_\_\_  
 5. Private Claims \_\_\_\_\_

Register of Deeds Stamp & File Number

|    |    |    |    |    |    |    |   |   |   |   |   |   |
|----|----|----|----|----|----|----|---|---|---|---|---|---|
| A  | B  | C  | D  | E  | F  | G  | H | I | J | K | L | M |
| 2  | 6  | 5  | 4  | 3  | 2  | 1  |   |   |   |   |   |   |
| 3  |    |    |    |    |    |    |   |   |   |   |   |   |
| 4  | 7  | 8  | 9  | 10 | 11 | 12 |   |   |   |   |   |   |
| 5  |    |    |    |    |    |    |   |   |   |   |   |   |
| 6  | 18 | 17 | 16 | 15 | 14 | 13 |   |   |   |   |   |   |
| 7  |    |    |    |    |    |    |   |   |   |   |   |   |
| 8  | 19 | 20 | 21 | 22 | 23 | 24 |   |   |   |   |   |   |
| 9  |    |    |    |    |    |    |   |   |   |   |   |   |
| 10 | 30 | 29 | 28 | 27 | 26 | 25 |   |   |   |   |   |   |
| 11 |    |    |    |    |    |    |   |   |   |   |   |   |
| 12 | 31 | 32 | 33 | 34 | 35 | 36 |   |   |   |   |   |   |
| 13 |    |    |    |    |    |    |   |   |   |   |   |   |

I, MARK R. ROBISON, in a field survey on JULY, 19 95, do hereby certify that under requirements of P.A. 74, Michigan P.A. of 1970, the corner points mentioned in lines 1 and 2 above were in conformance with regulations and rules therefore as required in the current manual of survey instructions of the United States Department of the Interior, Bureau of Land Management or by a decree of a Court of Law and/or that the corner points mentioned in lines 3, 4 and 5 above were in conformance with the rules of the Michigan Board of Professional Surveyors or by a Decree of a Court of Law; established, re-established, monumented, re-monumented, recovered, found as expressed below:

**NOTE: Not more than 4 corners, all in the same town and range, may be recorded on this certificate.**

- A. Description of original monument and accessories and/or subsequent restoration:
- 1838 NICHOLSON - TWP. LINE
  - 1856 CANNON - FD. POST  
HEMLOCK 9 S25°E 25  
BEECH 12 N34°E 53
  - 6-03 JOHNSON - IRON BOLT, CSR  
CEDAR POST 8" N63°E 82' (54.12')  
MEAS 46.835' TO B-7 (3091.11')


SURVEY &  
 RE-MONUMENTATION  
 DEC 01 1995  
 COMMISSION

- B. Description of corner evidence found and/or method applied in restoring or reestablishing corner:
- FOUND 1 3/4"x18" R.R. COUPLING PIN (BOLT) IN T-ROAD EAST, APPROX. 6' WEST OF C OF N-S ROAD.
  - FENCE LINE 34 1/2 FEET WEST.
  - N63°E 54 FEET FALLS ON BACK EDGE OF DITCH BANK.

**APPROVED LAND CORNER**  
 P.A. 345 of 1990  
 Clare County  
 Chairman Paul S. Apple  
 Date 9-26-95

This Corner established in Clare County Remonumentation Program.  
 See dossier for detailed report.

- C. Description of monument for corner and accessories established to perpetuate locating the position of the corner:
- A-7, 18-19 SEC CORNER ON TWP. LINE.
  - SET 5/8"x36" RE-ROD WITH 3" CLARE COUNTY MOUNUMENT CAP.
  - ACCEPTED AS BEST AVAILABLE EVIDENCE OF THE PERPETUATION OF THE C.S.R. CORNER.
  - N45°W 21.95' N&T IN 12" TWIN ASH
  - N30°E 61.71' N&T IN ANGLE FENCE POST
  - N65°E 79.48' N&T IN P.P.
  - S15°W 92.91' N&T IN 16" TRIPLE ASH (NORTH)

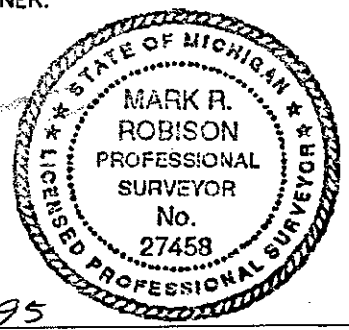

Signed by Mark R. Robison  
 Surveyor's Michigan License No. 27458

Date 10-03-95  
 FORM APPROVED BY MICHIGAN STATE BOARD OF PROFESSIONAL SURVEYORS, JAN. 28, 1971  
 REVISED MAY 14, 1975  
 REVISED JAN., 1983