

SURVEY & REMONUMENTATION

JAN 14 1999

CLARE County Remonumentation

SECTION

LAND CORNER RECORDATION CERTIFICATE
Filing Requirement of Act 74, Mich. P.A. 1970

For corners in

CLARE Located in: Corner Code #
(County)

1. Public Land Survey T18N R03W F-5
T R
T R
T R

2. Property Controlling S T R
in Section S T R

3. Miscellaneous S T R
Property in Sec. S T R

RECEIVED
#316-98
98 DEC 29 PM 3:04
REGISTER OF DEEDS
CLARE COUNTY
CAROL A. McAULAY

Register of Deeds Stamp & File Number

4. Lot No. _____, Recorded Plat _____
5. Private Claims _____

I, Mark R Robison, in a field survey on October, 1998 do hereby state that under requirements of P.A. 74, Michigan P.A. of 1970, the corner points mention in lines 1 and 2 above were in conformance with regulations and rules therefore as required in the current manual of survey instructions of the United States Department of the Interior, Bureau of Land Management or by a decree of a Court of Law and/or that the corner points mentioned in lines 3, 4 and 5 above were in conformance with the rules of the Michigan Board of Land Surveyors or by a Decree of a Court of Law; established, re-established, monumented, recovered, found as expressed below:

1	A	B	C	D	E	F	G	H	I	J	K	L	M
2	6		5		4		3		2		1		
3													
4	7		8		9		10		11		12		
5													
6	18		17		16		15		14		13		
7													
8	19		20		21		22		23		24		
9													
10	30		29		28		27		26		25		
11													
12	31		32		33		34		35		36		
13													

NOTE: Not more than 2 corners, all in the same town and range, may be recorded on this certificate

A. Description of original monument and accessories and/or subsequent restoration:

F-5: 1856 Cannon 1978 Lapham, LCRC #326
West 40.75 Old 1/4 Post Set 1/2" C.I. Single Proportional Meas. to G.L.O.
Hemlock 24 N60E 40 S40E 61.77 3" Pine
Hemlock 24 S40W 48 South 36.79 Fence Post
81.53 to Sec. Corner N20W 39.79 Fence Post
N45E 67.35 20" Box Elder

1903 Johnson, CSR 5-26
No witnesses or distances 1982 Merry, (132) 2-707
Found 1/2" rod
Meas. West 2669.54

1907 Johnson, CSR 4-52, 5-104
White Pine 60 S8E 78
Inside Corner of House N18E, 137-1/2
Meas. East 40.48
Meas. West 40.50

B. Description of corner evidence found and/or method applied in restoring or reestablishing corner:

F-5: Found 1/2"x" re-rod in Mon. Box 2.5' North of centerline of pavement. Meas. West 2668.20 (G.L.O. proportional 2669.22 & CSR 2673 & 2671.68). Meas. East 2666.96 (G.L.O. proportional 2665.94). Found four 1978 witnesses. Fence line to South. Possible G.L.O. swales have been practically eliminated due to farming.


See dossier for detailed information

C. Description of monument for corner and accessories established to perpetuate locating the position of the corner:

F-5: Set 5/8" x 36" re-rod with Clare Co. Remon Cap Marked P.S. 27458 in Mon Box. Accepted as best available evidence of the accepted position of the corner.

N38E 67.35 N & T in 36" Box Elder (OBT)
S34E 60.86 N & T in 9" Red Pine (OBT)
N41W 39.99 N & T in Corner Fence Post (OBT)
South 37.22 N & T in Corner Fence Post (OBT)

APPROVED LAND CORNER
P.A. 345 of 1990
Clare County
Chairman [Signature]
Date 12-08-98

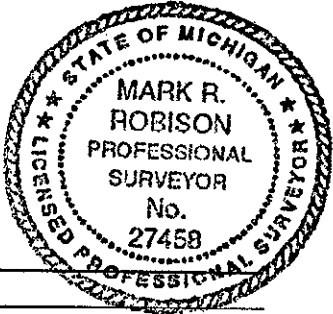

Signed by [Signature]
Surveyor's Michigan License No. 27458

Date 12-23-98