

**SURVEY & REMONUMENTATION**

JAN 14 1999

**SECTION**

CLARE County Remonumentation

**LAND CORNER RECORDATION CERTIFICATE**  
Filing Requirement of Act 74, Mich. P.A. 1970

For corners in

<u>CLARE</u> (County)	Located in:	Corner Code #
1. Public Land Survey	T18N R03W	G-5
	T ___ R ___	_____
	T ___ R ___	_____
	T ___ R ___	_____
2. Property Controlling in Section	S ___ T ___ R ___	_____
	S ___ T ___ R ___	_____
3. Miscellaneous Property in Sec.	S ___ T ___ R ___	_____
	S ___ T ___ R ___	_____

RECEIVED  
#315-98  
98 DEC 29 PM 3:04  
REGISTER OF DEEDS  
CLARE COUNTY  
CAROL A. MAULAY

Register of Deeds Stamp & File Number

4. Lot No. \_\_\_\_\_, Recorded Plat \_\_\_\_\_  
5. Private Claims \_\_\_\_\_

I, Mark R Robison, in a field survey on October, 1998 do hereby state that under requirements of P.A. 74, Michigan P.A. of 1970, the corner points mention in lines 1 and 2 above were in conformance with regulations and rules therefore as required in the current manual of survey instructions of the United States Department of the Interior, Bureau of Land Management or by a decree of a Court of Law and/or that the corner points mentioned in lines 3, 4 and 5 above were in conformance with the rules of the Michigan Board of Land Surveyors or by a Decree of a Court of Law; established, re-established, monumented, recovered, found as expressed below:

**NOTE: Not more than 2 corners, all in the same town and range, may be recorded on this certificate**

1	A	B	C	D	E	F	G	H	I	J	K	L
2		6		5		4		3		2		1
3												
4		7		8		9		10		11		12
5												
6		18		17		16		15		14		13
7												
8		19		20		21		22		23		24
9												
10		30		29		28		27		26		25
11												
12		31		32		33		34		35		36
13												

**A. Description of original monument and accessories and/or subsequent restoration:**

G-5: 1856 Cannon, GLO North 80.69, Int E-W Sec line at post No new witnesses	1907 Johnson, CSR 5-104 Corner of School house S52-1/2W 142-1/2 Meas. West 40.48 & 40.50	1982 Mueller, (132) 2-765 Found Nail & Tag in pvm't as recorded Meas. East 5234.15 Meas. South 2626.75
1911 Johnson, CSR 4-51 Corner of School house S52-1/2W 142-1/2	1909 Johnson, CSR 5-159 Corner of School house S 52-1/2W 142-1/2	1996 McVean, LCRC #821 Found old wood hub (C.S.R.) Replaced with 4" Alum Cap on 1" x 36" w/ ring of stone in Mon Box S50W 94.10 NE Cor Conc & Stone Fdn (CSR) N69W 74.40 24" Ash S50E 46.35 U.P. N50E 71.30 3" Red Pine S80W 207.31 10" Red Oak S14-33W 3.60 Nail & Tag #18664
1907 Johnson, CSR 4-52 Corner of School house S52-1/2W 142-1/2 Meas. 80.98 West	1978 Lapham, LCRC # 326 Found Nail & Tag N18W 70' 8" Cherry N75W 74.8' 6" Maple S50W 91.15 NE Corner School	
1903 Johnson, CSR 5-26 No Information		

**B. Description of corner evidence found and/or method applied in restoring or reestablishing corner:**

G-5: Found D.N.R. monument in Mon Box 1.5' North of C.L. Pvm't. Found all 1996 witnesses. Got reaction under pavement at position of 1978 corner. Accepted D.N.R. monument as position of the section corner.

See dossier for detailed information.

**C. Description of monument for corner and accessories established to perpetuate locating the position of the corner:**

G-5: Accepted D.N.R. monument in Mon. Box as Clare County Remonumentation Monument. Accepted as best available evidence of the perpetuation of the G.L.O. corner.

S50W, 94.10 N.E. Cor Conc & Stone Fdn. (OBT)  
N69W, 74.40 N & T in 24" Ash (OBT)  
N50E, 71.30 N & T in 4" Red Pine  
S50E, 46.35 N & T in Utility Pole (OBT)

**APPROVED LAND CORNER**

P.A. 345 of 1990


Clare County

Chairman Paul S. Lyle

Date 12-08-98

Signed by Mark R. Robison

Surveyor's Michigan License No. 27458

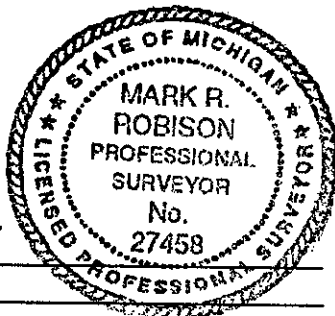

Date 12-23-98