

LAND CORNER RECORDATION CERTIFICATE
Filing Requirement of Act 74, Mich. P.A. 1970

RECEIVED

For corners in

CLARE
(County)

Located In:

Corner Code #

1. Public Land Survey

T 18N R 3W
T 19N R 3W

1-1
1-13

2. Property Controlling
In Section

S T R
S T R

3. Miscellaneous
Property in Sec.

S T R
S T R

144-96
96 NOV 14 PM 4:14

REGISTER OF DEEDS
CLARE COUNTY
DONNA M. CARR

Register of Deeds Stamp & File Number

4. Lot No. _____, Recorded Plat _____

5. Private Claims _____

I, MARK R. ROBISON, in a field survey on AUGUST, 19 96 do hereby state that under requirements of P.A. 74, Michigan P.A. of 1970, the corner points mentioned in lines 1 and 2 above were in conformance with regulations and rules therefore as required in the current manual of survey instructions of the United States Department of the Interior, Bureau of Land Management or by a decree of a Court of Law and/or that the corner points mentioned in lines 3, 4 and 5 above were in conformance with the rules of the Michigan Board of Land Surveyors or by a Decree of a Court of Law; established, re-established, monumented, recovered, found as expressed below:

| | A | B | C | D | E | F | G | H | I | J | K | L | M |
|----|----|---|---|----|---|---|----|---|----|---|----|---|----|
| 1 | | | | | | | | | | | | | |
| 2 | 6 | | | 5 | | | 4 | | 3 | | 2 | | 1 |
| 3 | | | | | | | | | | | | | |
| 4 | 7 | | | 8 | | | 9 | | 10 | | 11 | | 12 |
| 5 | | | | | | | | | | | | | |
| 6 | 18 | | | 17 | | | 16 | | 15 | | 14 | | 13 |
| 7 | | | | | | | | | | | | | |
| 8 | 19 | | | 20 | | | 21 | | 22 | | 23 | | 24 |
| 9 | | | | | | | | | | | | | |
| 10 | 30 | | | 29 | | | 28 | | 27 | | 26 | | 25 |
| 11 | | | | | | | | | | | | | |
| 12 | 31 | | | 32 | | | 33 | | 34 | | 35 | | 36 |
| 13 | | | | | | | | | | | | | |

NOTE: Not more than 2 corners, all in the same town and range, may be recorded on this certificate.

A. Description of original monument and accessories and/or subsequent restoration:

1838 NICHOLSON, G.L.O.
WIT.-MAPLE 8" N81°E 28 LKS.
MAPLE 9" N76°W 19 LKS.

7-03-03 JOHNSON, C.S.R. L.1, PG.21 &
L.4, PG. 23.
WIT.-ALL STAKES FOUND
I-1 TO I-2 40.84

5-30-73 COURTRIGHT, L.C.R.C. #104
WIT.-RESET P.K. NAIL FROM HWY. MAPS
FOR M-61
S40°E 85.50' FENCE POST
S40°W 82.34' FENCE POST
N05°W 52.75 6" ELM

10-10-03 JOHNSON, C.S.R. L.1, PG.23 &
L.4, PG. 30
WIT.-STAKE
NO WITNESSES

UNDATED SURVEYOR NOT NOTED
WIT.-I-1 TO I-3 81.13'

7-27-75 FLUHARTY (132) L.2, PG. 75
WIT.-FOUND P.K. NAIL 2617.67' TO H-1
SAME WITNESSES AS 5-30-73

UNDATED SURVEYOR NOT NOTED C.S.R. L.5, PG. 38
WIT.-S55°W, 55 LKS. FENCE POST
N47°W, 66 1/2 LKS. FENCE POST

MSHD R/W PLANS
WIT.-SEC. COR. AT STA. 319 & 77.1
NO WITNESSES

1-10-76 FLUHARTY L.C.R.C. #219
WIT.-SAME AS 7-27-75

B. Description of corner evidence found and/or method applied in restoring or reestablishing corner:


FOUND MON. BOX AT INTER. CENTER-LINES M-61 AND BAILEY LAKE AVENUE. NO IRON IN BOX. DID NOT FIND 1973 WITNESSES. MEAS. WEST 2617.70' (REC. 2617.67') TO H-1, MEAS. 5350.92' TO K-1. MEAS. SOUTH 5360.06' (GLO & CSR 5354.58') TO I-3.

See dossier for detailed report.

C. Description of monument for corner and accessories established to perpetuate locating the position of the corner:

SET 5/8"x36" RE-ROD WITH 3" CLARE COUNTY MONUMENT CAP IN EXISTING MONUMENT BOX. ACCEPTED AS BEST AVAILABLE EVIDENCE OF THE ACCEPTED POSITION OF THE CORNER.

WITNESSES:
N46°E, 81.00' - NAIL & TAG IN 15" WILLOW.
NORTH, 93.00' - NAIL & TAG IN 18" WILLOW.
S27°E, 86.12' - NAIL & TAG IN COR. FENCE POST.
S13°E, 138.28' - NAIL & TAG IN 10" ASH.

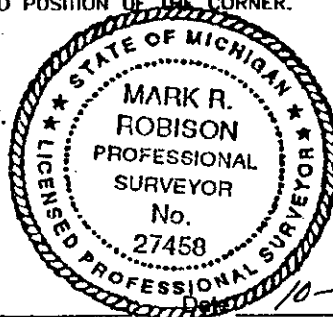

APPROVED LAND CORNER
P.A. 345 of 1990
Clare County

Chairman [Signature]
Date 11-07-96

Signed by Mark R. Robison
Surveyor's Michigan License No. 27458