

MAR 24 2000

SECTION LAND CORNER RECORDATION CERTIFICATE
Filing Requirement of Act 74, Mich. P.A. 1970
Clare County Remonumentation

For Corners in
Clare

Table with 3 columns: (County), Located In:, Corner Code#:
1. Public Land Survey T. 19N R. 6W F-13
T. 18N R. 6W F-1
2. Public Controlling S. T. R.
in Section S. T. R.
3. Miscellaneous S. T. R.
Property in Section S. T. R.
4. Lot No. Recorded Plat
5. Private Claims

199900009770
Filed for Record in
CLARE COUNTY MICHIGAN
CAROL MCAULAY
On 11-10-1999 At 01:30 pm.
LAND CORNER 9.00
OR Liber 2 Page 49 - 49

Instrument Liber Page
199900009770 OR 2 49

360-99

Register of Deeds Stamp & File Number

I, Mark R. Robison, in a field survey on 9-11-99, do hereby certify that under requirements of P.A. 74, Michigan P.A. of 1970, the corner points mentioned in lines 1 and 2 above were in conformance with regulations and rules therefore as required in the current manual of survey instructions of the United States Department of the Interior, Bureau of Land Management or by a decree of a Court of Law and/or that the corner points mentioned in lines 3, 4 and 5 above were in conformance with the rules of the Michigan Board of Land Surveyors or by a Decree of a Court of Law, established, re-established, monumented, re-monumented, recovered, found as expressed below.

Grid table with columns A-M and rows 1-13. Values range from 1 to 36.

NOTE: Not more than 2 corners, all in the same town and range, may be recorded on this certificate.

This is a single corner common to T19N, R6W, F-13 and T18N, R6W, F-1

A. Description of original monument and accessories and/or subsequent restoration:

1838 Rousseau
Set 1/4 Sec. Post
Swp. Ash 12, N80E 20
Swp. Ash 3, S12W 13

01-86 Roser LCRC #509 & Dwg. No 31-93124
Fd & accepted sucker rod for S1/4 Cor
added RLS cap.
N55W 98.28 P.P.
N85E 348.0 16" W. Pine
North 9' C.L. E-W Grd. Rd
North 33' Set Ced. Post
East 10' Old WW fence N'y
Meas. W 2617.69 to E-13
Meas. E 2617.34 to G-13

02-92 McClung, (132) 3-351
Same as LCRC #509

B. Description of corner evidence found and/or method applied in restoring or re-establishing corner:

See dossier for detailed report.
Found 5/8" x 24" female sucker rod, bent on top, on S. Side of E-W sand road across marsh area. Meas. East 2617.14' (D.N.R. 2617.34) to G-13. Found three D.N.R. witnesses. The P.P. and D.N.R. post falls in water in marsh.

C. Description of monument for corner and accessories established to perpetuate locating the position of the corner:


Set 5/8" x 36" rered with Clare Co. Remon Cap marked P.S. #27458. Accepted as best available evidence of the accepted position of the corner.

Witnesses:
North 32.68' Face of 6 x 6 DNR Post (OBT)
N84°E 348.54' Set N & T in 24" W. Pine (OBT)
S83°W 331.00' Set N & T in 18" W. Pine
N55°W 98.28' Accepted D.N.R. distance to P.P. (OBT)

APPROVED LAND CORNER
P.A. 345 of 1990
Clare County

Chairman Paul A. Leph
Date 9-29-99

Signed by Mark R. Robison
Surveyor's Michigan License No. 27458

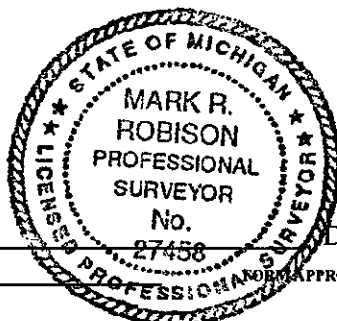

Date 11-8-99