

MAR 24 2000

SECTION

LAND CORNER RECORDATION CERTIFICATE
Filing Requirement of Act 74, Mich. P.A. 1970
Clare County Remonumentation

For Corners in
Clare

(County)	Located In:	Corner Code#:
1. Public Land Survey	T. <u>19N</u> R. <u>6W</u>	<u>J-13</u>
	T. <u>18N</u> R. <u>6W</u>	<u>J-1</u>
	T. _____ R. _____	_____
2. Public Controlling in Section	S. _____ T. _____ R. _____	_____
	S. _____ T. _____ R. _____	_____
3. Miscellaneous Property in Section	S. _____ T. _____ R. _____	_____
	S. _____ T. _____ R. _____	_____
4. Lot No. _____, Recorded Plat		_____
5. Private Claims		_____

199900009767
Filed for Record in
CLARE COUNTY MICHIGAN
CAROL MCAULAY
On 11-10-1999 At 01:30 pm.
LAND CORNER 9.00
OR Liber 2 Page 46 - 46

Instrument 199900009767 OR Liber 2 Page 46

#357-99

Register of Deeds Stamp & File Number

I, Mark R. Robison, in a field survey on August 11, 1999, do hereby certify that under requirements of P.A. 74, Michigan P.A. of 1970, the corner points mentioned in lines 1 and 2 above were in conformance with regulations and rules therefore as required in the current manual of survey instructions of the United States Department of the Interior, Bureau of Land Management or by a decree of a Court of Law and/or that the corner points mentioned in lines 3, 4 and 5 above were in conformance with the rules of the Michigan Board of Land Surveyors or by a Decree of a Court of Law, established, re-established, monumented, re-monumented, recovered, found as expressed below.

NOTE: Not more than 2 corners, all in the same town and range, may be recorded on this certificate.

This is a single corner common to
T19N, R6W, J-13 and T18N, R6W, J-1

	A	B	C	D	E	F	G	H	I	J	K	L	M
1													
2	6	5	4	3	2	1							
3													
4	7	8	9	10	11	12							
5													
6	18	17	16	15	14	13							
7													
8	19	20	21	22	23	24							
9													
10	30	29	28	27	26	25							
11													
12	31	32	33	34	35	36							
13													

A. Description of original monument and accessories and/or subsequent restoration:

1838 Rousseau	11-29-89 Lapham LCRC #596
Set 1/4 Sec Post	Fd 1/2" pipe w/cap on top
Hemlock 16 N71E 27	North 30.2 Fence Post
Hemlock 17 S40W 18	N45E 36.3 Fence Post
	East 25.38 Fence Post
8-24-06 & 1-23-07 Johnson	N38W 40.5 Fence Post
CSR 4-66, 4-81, 6-183	
Cedar Post 10" N62E 6	

10-3-94 Robison, (132) 3-474
Fd 1/2" Capped Pipe
Same witnesses as LCRC #596

APPROVED LAND CORNER
P.A. 845 of 1990
Clare County

Chairman *Paul S. Lepke*

B. Description of corner evidence found and/or method applied in restoring or re-establishing corner Date 9-29-99


See dossier for detailed report.

Found 1" x 24" iron bar surrounded by broken glass to depth of 18". Found two 1989 witnesses. Corner falls on extended C.L. gravel road S & W. Excavated to 24" and hit large stones. Meas. W 2629.04 to I-13. Found fence line North and East.

C. Description of monument for corner and accessories established to perpetuate locating the position of the corner:

Set 5/8" x 28" rered with Clare Co. Remon Cap marked P.S. #27458. Accepted as best available evidence of the accepted position of the corner.

Witnesses:
N05°E 29.45 Set N & T in RR tie F. Post (OBT)
N85°E 25.18 Set N & T in RR tie F. Post (OBT)
S44°W 61.70 Set N & T in 6" Cherry
N60°W 59.88 Set N & T in 10" Elm

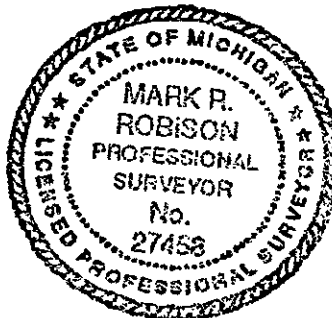

Signed by *Mark R. Robison*

Date 11/8/99

Surveyor's Michigan License No. 27458