

LAND CORNER RECORDATION CERTIFICATE

FILING REQUIREMENT OF ACT 74, MICH. P.A.1970

FOR CORNERS OF -:	LOCATED IN -:	CORNER CODE NUMBER
1. PUBLIC LAND SURVEY _____ T. <u>18</u> N. <u>06</u> R. <u>06</u> W. <u>06</u>		A-1, A-2, A-3
2. PROPERTY CONTROLLING IN SECTION <u>6</u> , T. <u>18</u> N. <u>06</u> R. <u>06</u> W. <u>06</u>		8, 10
3. MISCELLANEOUS PROPERTY IN SECTION _____, T. _____ N. _____ R. _____ E. _____ W. _____		
4. LOT NO. _____, RECORDED PLAT _____		
5. PRIVATE CLAIMS _____		

REGISTER OF DEEDS STAMP AND FILING NUMBER

I, CARL F. ROSER, do hereby certify that under requirements of P.A. 74, Michigan P.A. of 1970, the corner points mentioned in lines 1 and 2 above were, in a field survey on JANUARY 29, 1985, established, re-established, monumented, re-monumented, recovered or restored as expressed below and in conformance with regulations and rules therefore as required in the current manual of survey instructions of the United States Department of the Interior, Bureau of Land Management or by a decree of a court of law. Furthermore, that the corner points mentioned in lines 3, 4 and 5 above were, in a field survey on _____, 19____, found, recovered, restored, established or re-established as expressed below and in conformance with the rules of the Michigan State Board of Registration for Land Surveyors or, by a Decree of a Court of law:

A. Description of original monument and accessories and/or subsequent restoration:

<p>A-3 FD OSCEOLA CO MON & PIECES OF TILE; ADDED CED POST. 8" MAPL CLUMP N80°W 36.4' 6" ASH N10°E 71.9' 5" BALSAM N65°E 29.7' 4" BALSAM S65°E 20.0' CTR TRL NE & SW S60°E 7'</p>	<p>8 SET 5/8" X 34" REROD W/RLS CAP & CED POST W/LOC TAG. 6" & 5" MAPLE N45°E 60.1' 9" TRIPL MAPL S60°E 101.7 CTR M115 S65°W 72' 4" X 4" CONC R/W POST N65°W 66'</p>	<p>10 SET 5/8" X 34" REROD W/RLS CAP & CED POST W/LOC TAG. CTR N-S TRAIL DUE E 117' 6" B OAK N70°E 23.1' 4" R OAK S75°E 20.9' 5" BALSAM S10°W 8.2' 4" BALSAM N45°W 4.2'</p>
--	--	---

B. Description of corner evidence found and/or method applied in restoring or re-establishing corner:

- A-1 RESTORED FOUR TWP COR; COR COMM TO T18 & 19N, R6 & 7W, CALC. POINT IN MUSKEGON RIVER-NO POINT SET; ON LINE ACROSS FD CONC MON FOR SW COR OF LOT 1 OF "ASSESSORS PLAT OF MUSKEGON BANKS" & FD OSCEOLA CO MON FOR W 1/4 COR OF SEC 31 (T19N, R6W) INTERSEC WITH LINE ACROSS FD S 1/4 COR (1" PIPE) & FD SE COR (1/2" PIPE) OF SEC 31, T19N, R6W.
- A-2 FD & ACCEPTED OSCEOLA CO MON FOR W 1/4 COR, SEC 6.
- A-3 FD & ACCEPTED OSCEOLA CO MON FOR SW COR OF SEC 6. FD REMAINS OF TILE & FITS M. MCCLUNG WIT & A. JOHNSON WIT.
- 8 ESTAB NW COR OF NE 1/4 OF SW 1/4 OF SEC 6 PER STD B.L.M. INSTRUCTIONS.
- 10 ESTAB NW COR OF SW 1/4 OF SW 1/4 OF SEC 6 PER STD B.L.M. INSTRUCTIONS.

C. Description of monument for corner and accessories established to perpetuate locating the position of the corner:

<p>A-1 CALC FOUR TWP COR IN MUSKEGON RV. FD 1/2" PIPE (1937 MSHD REF COR) -----S01°15'58"E 102.41' W 1/4 COR, SEC 6 (FD OSCEOLA CO MON) -----S00°29'20"W 2506.50' W 1/8 COR ON N LINE SEC 6 SET 5/8 X 34" REROD -----N87°15'40"E 1234.30' FD CONC MON (SW COR OF LOT 1 OF ASSESS. PLAT)---N01°23'01"W 113.45' W 1/4 COR SEC 31, T19N, R6W (FD OSCEOLA CO MON)---N01°23'01"W 2638.92'</p>	<p>A-2 FD OSCEOLA CO MON, ADDED CED POST 10" ASH N55°E 8.9' 9" CEDAR S85°E 15.5' 9" CEDAR S05°W 19.5' 7" CEDAR S40°W 13.3'</p>
--	--

SIGNED BY Carl F. Roser 01-06-86 DATE _____


SURVEYOR'S MICHIGAN REGISTRATION NO. 12028

FOR STATE AND UNITED STATES AGENCIES:

SIGNED BY _____ DATE _____

APPROVED AND SIGNED BY _____ DATE _____

SURVEYOR'S MICHIGAN REGISTRATION NO. _____

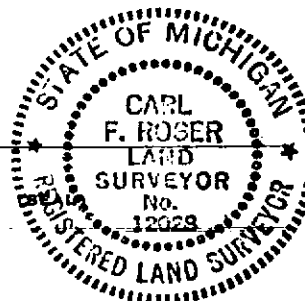

(SEAL)
FREEMAN TWP.
CLARE COUNTY