


Freeman TOWNSHIP
T. 18 N., R. 6 W.
CLARE COUNTY

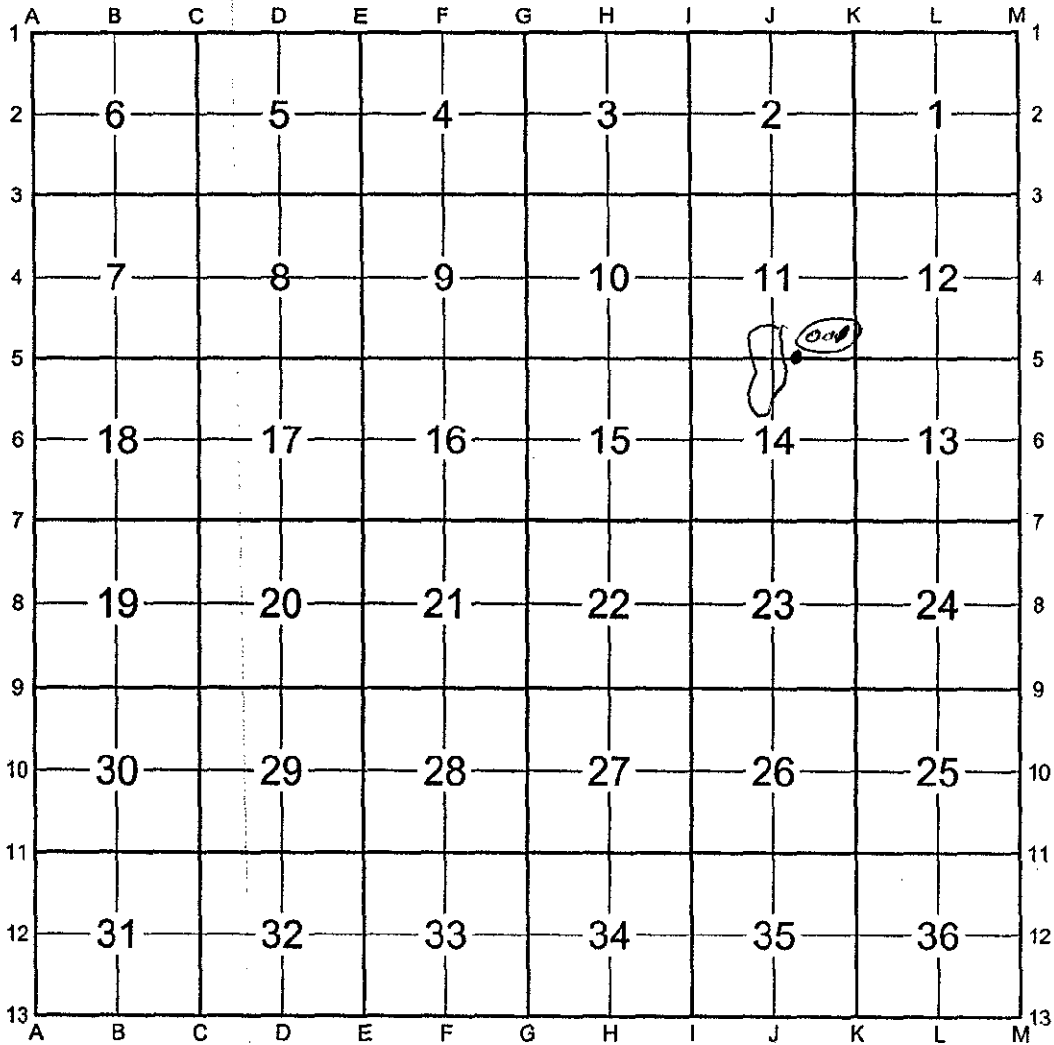

M.C. #001 recorded in Liber 2, Page 265



0 6000
SCALE 1" = 6000'

SURVEY &
REMONUMENTATION
JAN 23 2001
SECTION