

CLARE COUNTY REMONUMENTATION

LAND CORNER RECORDATION CERTIFICATE
Filing Requirement of Act 74, Mich. P.A. 1970

RECEIVED
#186-96
96 DEC 23 AM 11:59
REGISTER OF DEEDS
CLARE COUNTY
DONNA M. CARR

For corners in

CLARE (County)	Located In:	Corner Code #
1. Public Land Survey	T 18N R 4W	D - 7
	T R	
	T R	
	T R	
2. Property Controlling in Section	S T R	
	S T R	
3. Miscellaneous Property in Sec.	S T R	
	S T R	

Register of Deeds Stamp & File Number

4. Lot No. _____, Recorded Plat _____
5. Private Claims _____

I, MARK R. ROBISON, in a field survey on November, 19 96 do hereby state that under requirements of P.A. 74, Michigan P.A. of 1970, the corner points mentioned in lines 1 and 2 above were in conformance with regulations and rules therefore as required in the current manual of survey instructions of the United States Department of the Interior, Bureau of Land Management or by a decree of a Court of Law and /or that the corner points mentioned in lines 3, 4 and 5 above were in conformance with the rules of the Michigan Board of Land Surveyors or by a Decree of a Court of Law, established, re-established, monumented, recovered, found as expressed below:

	A	B	C	D	E	F	G	H	I	J	K	L	M
1													
2	6		5		4		3		2		1		
3													
4	7		8		9		10		11		12		
5													
6	18		17		16		15		14		13		
7													
8	19		20		21		22		23		24		
9													
10	30		29		28		27		26		25		
11													
12	31		32		33		34		35		36		
13													

NOTE: Not more than 2 corners, all in the same town and range, may be recorded on this certificate.

A. Description of original monument and accessories and/or subsequent restoration:

1856 CANNON
WIT.-BEECH 10" N31W 25L
YELLOW PINE 14" S23E 16L

NOTES INDICATE COR. SET S.P.M. BETWEEN C-7 & I-7
MEAS W 2647.87 (GLO 2656.5) TO C-7

NO CO. SURVEY RECORDS

1-16-75 LAPHAM-LCRC
WIT.-SAME AS 11-11-74 SURVEY

11-11-74 SEDGMAN (132) SURVEY
SET 1/2" CAPPED REROD
WIT.-S10E 119.49 36" OAK
S25E 70.58 36" OAK
N45W 145.24 30" OAK

B. Description of corner evidence found and/or method applied in restoring or reestablishing corner:

FOUND 1/2" X 18" REROD WITH J.S. CAP 0.4' NORTH OF OLD FENCE CORNER. FOUND ALL 1974 WITNESSES. FOUND NO OTHER EVIDENCE.

APPROVED LAND CORNER
P.A. 345 of 1990
Clare County

Chairman Paul H. Leph


Date 11-14-96

SEE DOSSIER FOR DETAILED REPORT.

C. Description of monument for corner and accessories established to perpetuate locating the position of the corner:

D-7: 1/4 CORNER COMMON TO SECTIONS 17 & 20
SET 5/8" X 36" REROD WITH 3" CLARE COUNTY MONUMENT CAP. ACCEPTED AS BEST AVAILABLE EVIDENCE OF ACCEPTED POSITION OF CORNER.

WITNESSES:
SOUTH 119.49 N&T IN 44" OAK (OBT)
S25W 70.58 N&T IN 44" OAK (OBT)
N40W 145.24 N&T IN 40" OAK (OBT)
S38E 37.00 N&T IN 14" OAK

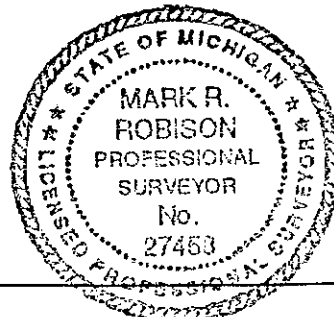

Signed by Mark R. Robison
Surveyor's Michigan License No. 27458

Date 12-20-96