

**SURVEY &  
REMONUMENTATION**

**JAN 23 2001**

**LAND CORNER RECORDATION CERTIFICATE**

**Filing Requirement of Act 74, Mich. P.A. 1970**

**SECTION**

**Clare County Remonumentation**

For Corners in  
Clare

(County)

Located In:

Corner Code#:

- 1. Public Land Survey T. 19N R. 4W I-13  
T. 18N R. 4W I-1 ✓  
T. \_\_\_\_\_ R. \_\_\_\_\_ \_\_\_\_\_
- 2. Public Controlling S. \_\_\_\_\_ T. \_\_\_\_\_ R. \_\_\_\_\_  
in Section S. \_\_\_\_\_ T. \_\_\_\_\_ R. \_\_\_\_\_
- 3. Miscellaneous S. \_\_\_\_\_ T. \_\_\_\_\_ R. \_\_\_\_\_  
Property in Section S. \_\_\_\_\_ T. \_\_\_\_\_ R. \_\_\_\_\_
- 4. Lot No. \_\_\_\_\_, Recorded Plat \_\_\_\_\_
- 5. Private Claims \_\_\_\_\_

20000009279  
Filed for Record in  
CLARE COUNTY MICHIGAN  
CAROL MCAULAY  
On 11-14-2000 At 11:04 am.  
LAND CORNER 9.00  
OR Liber 2 Page 205 - 205

Instrument Liber Page  
20000009279 OR 2 205

# 410-00

**Register of Deeds Stamp & File Number**

I, Mark R. Robison, in a field survey on May 9, 2000, do hereby certify that under requirements of P.A. 74, Michigan P.A. of 1970, the corner points mentioned in lines 1 and 2 above were in conformance with regulations and rules therefore as required in the current manual of survey instructions of the United States Department of the Interior, Bureau of Land Management or by a decree of a Court of Law and/or that the corner points mentioned in lines 3, 4 and 5 above were in conformance with the rules of the Michigan Board of Land Surveyors or by a Decree of a Court of Law, established, re-established, monumented, re-monumented, recovered, found as expressed below.

**NOTE: Not more than 2 corners, all in the same town and range, may be recorded on this certificate.**

This is a single common corner to T19N, R4W, & T18N, R4W.

	A	B	C	D	E	F	G	H	I	J	K	L	M
1													
2	6	5	4	3	2	1							
3													
4	7	8	9	10	11	12							
5													
6	18	17	16	15	14	13							
7													
8	19	20	21	22	23	24							
9													
10	30	29	28	27	26	25							
11													
12	31	32	33	34	35	36							
13													

A. Description of original monument and accessories and/or subsequent restoration:

- GLO  
Nicholson, 1838  
Cedar 15" N34°E, 39 LINKS  
Pine 22" N43°W,  
C.S.R.  
Unknown, Circa 1900 Bk. 6 Pg. 183  
W. Pine 20" S21 1/2°W 38 LINKS
- GLO  
Cannon, 1856  
W. Pine 30" S58°W, 57 LINKS  
W. Pine 23" S70°E, 38 LINKS  
LCRC, Sedgman, 1975, #230-76  
Found 5/8" bar, 3 witnesses
- C.S.R.  
Moore, 1956, Bk. 3 Pg. 47  
Iron in pavement at intersection of centerlines  
I-1 to J-1 = 2643.8  
Survey, Sedgman, 1975, L2. Pg. 107  
Same as LCRC #230-76

Survey, Sedgman, 1978, L2. Pg. 359  
Same as LCRC #230-76

Private Files - Lapham, 1975  
I-1 to J-1 = 2643.92

**APPROVED LAND CORNER**  
P.A. 345 of 1990  
Clare County


Chairman Paul H. Lapham  
Date 8-30-00

B. Description of corner evidence found and/or method applied in restoring or re-establishing corner.

No GLO evidence found. Found 5/8" x 18" rerod in Mon. Box and 3 LCRC witnesses. Irons position matches 1956 CSR call closely. Currently 1.4' South of centerline M-61, 6' East of trail North and on centerline of old grade south. 1956 CSR matches 1975 distances. Meas. West 2634.74 to H-1 and East 2643.92 to J-1. Accepted found iron as best available evidence of the accepted position of the corner.

C. Description of monument for corner and accessories established to perpetuate locating the position of the corner:

- Set 5/8" x 36" rerod in Mon. Box with Clare County Remon Cap marked P.S. #27458.
- Witnesses:  
S50°E, 76.05' - N & T in 10" Cedar (OBT)  
N30°E, 67.88' - N & T in 10" Cedar (OBT)  
N34°W, 66.13' - N & T in 10" x 14" Cedar (OBT)  
S24°W, 81.78' - Center of concrete R/W marker

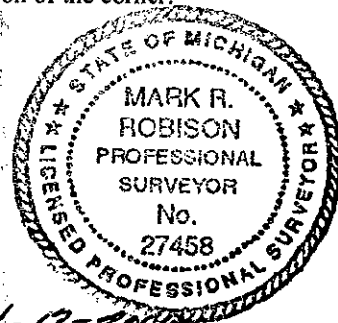

Signed by Mark R. Robison  
Surveyor's Michigan License No. 27458

Date 11-13-2000