

**SURVEY &  
REMONUMENTATION**

**JAN 23 2001 LAND CORNER RECORDATION CERTIFICATE**

**Filing Requirement of Act 74, Mich. P.A. 1970**

**SECTION**

**Clare County Remonumentation 20000009282**

For Corners in  
Clare

Filed for Record in  
CLARE COUNTY MICHIGAN  
CAROL MCAULAY  
On 11-14-2000 At 11:04 am.  
LAND CORNER 9.00  
OR Liber 2 Page 208 - 208

(County)	Located In:	Corner Code#:
1. Public Land Survey	T. <u>18N</u> R. <u>4W</u>	<u>L-1</u> ✓
	T. <u>19N</u> R. <u>4W</u>	<u>L-13</u>
	T. <u>    </u> R. <u>    </u>	<u>    </u>
2. Public Controlling in Section	S. <u>    </u> T. <u>    </u> R. <u>    </u>	<u>    </u>
	S. <u>    </u> T. <u>    </u> R. <u>    </u>	<u>    </u>
3. Miscellaneous Property in Section	S. <u>    </u> T. <u>    </u> R. <u>    </u>	<u>    </u>
	S. <u>    </u> T. <u>    </u> R. <u>    </u>	<u>    </u>
4. Lot No. <u>    </u> , Recorded Plat <u>    </u>		
5. Private Claims <u>    </u>		

Instrument Liber Page  
20000009282 OR 2 208

#413-00

Register of Deeds Stamp & File Number

I, Mark R. Robison, in a field survey on May 9, 2000, do hereby certify that under requirements of P.A. 74, Michigan P.A. of 1970, the corner points mentioned in lines 1 and 2 above were in conformance with regulations and rules therefore as required in the current manual of survey instructions of the United States Department of the Interior, Bureau of Land Management or by a decree of a Court of Law and/or that the corner points mentioned in lines 3, 4 and 5 above were in conformance with the rules of the Michigan Board of Land Surveyors or by a Decree of a Court of Law, established, re-established, monumented, re-monumented, recovered, found as expressed below.

	A	B	C	D	E	F	G	H	I	J	K	L	M
1													
2	6	5	4	3	2	1							
3													
4	7	8	9	10	11	12							
5													
6	18	17	16	15	14	13							
7													
8	19	20	21	22	23	24							
9													
10	30	29	28	27	26	25							
11													
12	31	32	33	34	35	36							
13													

**NOTE: Not more than 2 corners, all in the same town and range, may be recorded on this certificate.**

This is a single corner common to T18N, R4W & T19N, R4W

A. Description of original monument and accessories and/or subsequent restoration:

GLO  
Nicholson, 1838  
Beech 7" N67°E, 28 LINKS  
Birch 6" N8°W, 27 LINKS

Survey, Fluharty, 1990 L3. Pg. 258  
Same as 3-256

APPROVED LAND CORNER  
P.A. 345 of 1990  
Clare County

Chairman Paul S. Lyle  
Date 8-30-00

Survey, Fluharty, 1990 L3. Pg. 256  
Set 5/8" iron, 4 witnesses  
Set by SPM at 2631.75 each way

B. Description of corner evidence found and/or method applied in restoring or re-establishing corner:


No GLO evidence found. Found 5/8" x 20" rerod with cap at 2631.75' from K-1 to L-1 & M-1 to L-1. Excavated to a depth of 1.5' and nothing else found. Found 4 witnesses from 1990 surveys. Accepted found iron as best available evidence of accepted position of the corner.

C. Description of monument for corner and accessories established to perpetuate locating the position of the corner:

Set 5/8" x 36" rerod with Clare County Remon Cap marked P.S. #27458.

Witnesses:

S85°W, 75' - N & T 40" x 36" R. Oak (OBT)  
N37°W, 26.08' - N & T 15" x 25" R. Oak (OBT)  
N10°E, 27.35' - N & T 12" R. Oak (OBT)  
S25°W, 56.11' - N/W Corner Blk Foundation of Hse (OBT)  
East, 21.14' - Capped Iron #18223 (Property corner per L-3, Pg. 258)

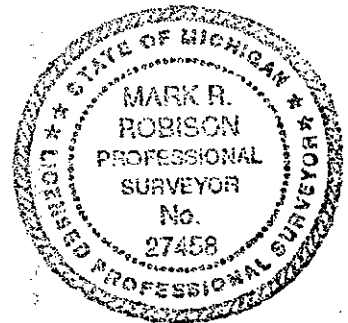

Signed by

Mark R. Robison

Date

11-13-2000

Surveyor's Michigan License No. 27458

FORM APPROVED BY MICHIGAN STATE BOARD OF LAND SURVEYORS, JAN. 28, 1971

REVISED MAY 14, 1975  
REVISED JAN., 1983