

DEC 1995

LAND CORNER RECORDATION CERTIFICATE
Filing Requirement of Act 74, Mich. P.A. 1970

RECEIVED
#117-95
95 OCT -3 PM 2:51
REGISTER OF DEEDS
CLARE COUNTY
DONNA M. CARR

For corners in CLARE Located In: _____ Corner Code # _____
(County)

1. Public Land Survey	T	<u>18N</u>	R	<u>4W</u>	<u>M-7</u>
	T	_____	R	_____	_____
	T	_____	R	_____	_____
	T	_____	R	_____	_____
2. Property Controlling in Section	S	_____	T	_____	R
	S	_____	T	_____	R
3. Miscellaneous Property in Section	S	_____	T	_____	R
	S	_____	T	_____	R

Register of Deeds Stamp & File Number

4. Lot No. _____, Recorded Plat _____
5. Private Claims _____

A	B	C	D	E	F	G	H	I	J	K	L
2	6	5	4	3	2						
3											
4	7	8	9	10	11	12					
5											
6	18	17	16	15	14	13					
7											
8	19	20	21	22	23	24					
9											
10	30	29	28	27	26	25					
11											
12	31	32	33	34	35	36					
13											

I, MARK R. ROBISON, in a field survey on JULY, 19 95, do hereby certify that under requirements of P.A. 74, Michigan P.A. of 1970, the corner points mentioned in lines 1 and 2 above were in conformance with regulations and rules therefore as required in the current manual of survey instructions of the United States Department of the Interior, Bureau of Land Management or by a decree of a Court of Law and/or that the corner points mentioned in lines 3, 4 and 5 above were in conformance with the rules of the Michigan Board of Professional Surveyors or by a Decree of a Court of Law; established, re-established, monumented, re-monumented, recovered, found as expressed below:

NOTE: Not more than 4 corners, all in the same town and range, may be recorded on this certificate.

A. Description of original monument and accessories and/or subsequent restoration:
1838 NICHOLSON - TWP. LINE

1856 CANNON - FD. POST
HEMLOCK 9 S25°E 25
BEECH 12 N34°E 53

6-03 JOHNSON - IRON BOLT CSR
CEDAR POST 8" N63°E 82 (54.12)
MEAS 46.835 TO B-7 (3091.11)

B. Description of corner evidence found and/or method applied in restoring or reestablishing corner:
FOUND 1 3/4"x18" R.R. COUPLING PIN (BOLT) IN T-ROAD EAST, APPROX. 6' WEST OF C OF N-S ROAD.
FENCE LINE 34 1/2 FEET WEST.
N63°E 54 FEET FALLS ON BACK EDGE OF DITCH BANK.

APPROVED LAND CORNER
P.A. 345 of 1990
Clare County

Chairman Paul A. Loph


Date 9-26-95

This Corner established in Clare County Remonumentation Program.

See dossier for detailed report.

C. Description of monument for corner and accessories established to perpetuate locating the position of the corner:

M-7: 13-24 SEC CORNER ON TWP. LINE.
SET 5/8"x36" RE-ROD WITH 3" CLARE COUNTY MOUNUMENT CAP.
ACCEPTED AS BEST AVAILABLE EVIDENCE OF THE PERPETUATION OF THE C.S.R. CORNER.
N45°W 21.95' N&T IN 12" TWIN ASH
N30°E 61.71' N&T IN ANGLE FENCE POST
N65°E 79.48' N&T IN P.P.
S15°W 92.91' N&T IN 16" TRIPLE ASH (NORTH)

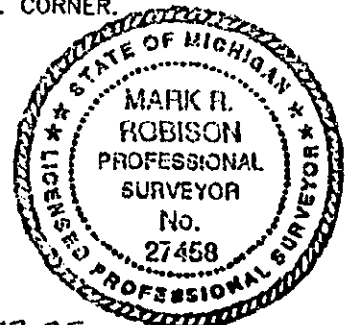

Signed by Mark R. Robison

Date 11-03-95

Surveyor's Michigan License No. 27458