

**SURVEY &  
REMONUMENTATION**

**JAN 23 2001**

**SECTION**

**LAND CORNER RECORDATION CERTIFICATE**

**Filing Requirement of Act 74, Mich. P.A. 1970**

**Clare County Remonumentation**

For Corners in  
Clare

200000010143  
Filed for Record in  
CLARE COUNTY MICHIGAN  
CAROL MCAULAY  
On 12-15-2000 At 07:44 am.  
LAND CORNER 9.00  
OR Liber 2 Page 266 - 266

(County)	Located In:	Corner Code#:
1. Public Land Survey	T. <u>18N</u> R. <u>5W</u>	<u>A-5</u> ✓
	T. <u>18N</u> R. <u>6W</u>	<u>M-5</u>
	T. _____ R. _____	_____
2. Public Controlling in Section	S. _____ T. _____ R. _____	_____
	S. _____ T. _____ R. _____	_____
3. Miscellaneous Property in Section	S. _____ T. _____ R. _____	_____
	S. _____ T. _____ R. _____	_____
4. Lot No. _____, Recorded Plat _____		
5. Private Claims _____		

Instrument Liber Page  
200000010143 OR 2 266

#471-00

Register of Deeds Stamp & File Number

I, Mark R. Robison, in a field survey on May 19, 2000, do hereby certify that under requirements of P.A. 74, Michigan P.A. of 1970, the corner points mentioned in lines 1 and 2 above were in conformance with regulations and rules therefore as required in the current manual of survey instructions of the United States Department of the Interior, Bureau of Land Management or by a decree of a Court of Law and/or that the corner points mentioned in lines 3, 4 and 5 above were in conformance with the rules of the Michigan Board of Land Surveyors or by a Decree of a Court of Law, established, re-established, monumented, re-monumented, recovered, found as expressed below.

1	A	B	C	D	E	F	G	H	I	J	K	L	M
2	6	5		4		3		2		1			
3													
4	7	8		9		10		11		12			
5													
6	18	17		16		15		14		13			
7													
8	19	20		21		22		23		24			
9													
10	30	29		28		27		26		25			
11													
12	31	32		33		34		35		36			
13													

**NOTE: Not more than 2 corners, all in the same town and range, may be recorded on this certificate.**

This is a single corner common to T18N, R5W, & T18N, R6W.

**A. Description of original monument and accessories and/or subsequent restoration:**

GLO Lyon, 1848 Beech 10" N57°W, 10 LINKS Beech 10" S43°W, 12 LINKS Beech 10" S33°E, 16 LINKS Maple 6" N43°W, 38 1/2 LINKS	Lapham, 1992 LCRC #669-92 Found P.K. Nail, 4 witnesses
C.S.R, Harper, 1902, Bk 1. Pg. 12 & Bk. 4 Pg. 14 W. Pine Stub 20" S18 1/2°W, 47 LINKS W. Pine Stump 18" N27°E, 75 LINKS	Lapham, 1995, LCRC #770-95 Found P.K. Nail, 4 witnesses with 2 the same as LCRC #669-92
	Survey, Robison, 1993 L3. Pg. 477 Same as LCRC #770-95 B-5 to A-5 = 2544.94 (GLO = 2514.6)


**B. Description of corner evidence found and/or method applied in restoring or re-establishing corner.**

No evidence of GLO survey found. Found spike and excavated to 2' and found nothing else. Found 3 witnesses from LCRC #770-95 with 1 in good shape. Measured to B-5 as 2544.58' to A-4 as 2636.77', to A-6 as 2622.67' and to L-5 (18N6W) as 2663.88'. Corner is 5' South of centerline East-West road (Mannsiding) and on centerline road to South (Hemlock). No evidence of another corner found. Accepted found spike as best available evidence of position of corner.

**C. Description of monument for corner and accessories established to perpetuate locating the position of the corner:**

Set 5/8"x 36" rod with Clare County Remon Cap marked P.S. #27458 in Monument Box.

Witnesses:  
N55°W, 45.95' - Center of telephone riser (OBT)  
N45°E, 53.76' - N & T in Fence Post  
S63°E, 74.58' - N & T in Power Pole  
S48°W, 49.94' - N & T in 17" Balsam

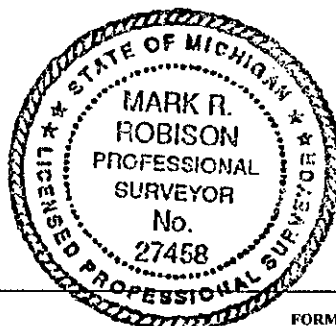

**APPROVED LAND CORNER**  
P.A. 345 of 1990  
Clare County

Chairman *[Signature]*  
Date 9-18-00

Signed by *[Signature]*  
Surveyor's Michigan License No. 27458

Date 12/14/2000