

REMON

NOV 18 1997

CLARE COUNTY REMONUMENTATION

LAND CORNER RECORDATION CERTIFICATE  
Filing Requirement of Act 74, Mich. P.A. 1970

For corners in

CLARE

(County)

Located In:

Corner Code #

1. Public Land Survey

T19N	R 5W	D-13
T18N	R 5W	D-1
T	R	
T	R	
S	T	R
S	T	R
S	T	R
S	T	R

2. Property Controlling in Section

3. Miscellaneous Property in Sec.

4. Lot No. \_\_\_\_\_, Recorded Plat \_\_\_\_\_  
5. Private Claims \_\_\_\_\_

I, MARK R. ROBISON, in a field survey on July 1, 19 97 do hereby state that under requirements of P.A. 74, Michigan P.A. of 1970, the corner points mentioned in lines 1 and 2 above were in conformance with regulations and rules therefore as required in the current manual of survey instructions of the United States Department of the Interior, Bureau of Land Management or by a decree of a Court of Law and/or that the corner points mentioned in lines 3, 4 and 5 above were in conformance with the rules of the Michigan Board of Land Surveyors or by a Decree of a Court of Law; established, re-established, monumented, recovered, found as expressed below:

NOTE: Not more than 2 corners, all in the same town and range, may be recorded on this certificate.

A. Description of original monument and accessories and/or subsequent restoration:

1838  
Set or. Sec. Post  
Wit.-W. Pine 30° S35E 14  
W. Pine 10° S12W 30  
No C.S.R. Records

6-15-73 Lapham (132) 1-504  
Set 1/2" rod on S.P.M.  
(2611.48' B.W.)  
Wit.-S30W 16.00 15' Oak  
South 45.89 18" Oak  
N40E 28.70 18" Oak

7-24-73 Lapham L.C.R.C.# 111  
Wit.-same as (132) 1-504

7-06-81 Sedgman (132) 2-659  
Wit.-same as (132) 1-504

12-3-82 Ward (132) 2-757  
Wit.-same as (132) 1-504

8-16-90 Robison  
Wit.-same as (132) 1-504

B. Description of corner evidence found and/or method applied in restoring or reestablishing corner:

Found 1/2" x 18" capped iron. Excavated to 4 feet. Found 30" x 2" pipe two feet deep. Corner fits posts to North and fence to West. Found all 1973 witnesses.

See dossier for detailed report.

APPROVED LAND CORNER  
P.A. 848 of 1990  
Clare County

Chairman Paul A. Lapham  
Date 9-16-97


C. Description of monument for corner and accessories established to perpetuate locating the position of the corner:

D-13: 1/4 Corner common to Section 32, T19N, R5W, AND Section 5, T18N, R5W, (D-1). Set 5/8" x 36" rod with 3" Clare County Monument Cap marked P.S.#27458. Accepted as best available evidence of the accepted position of the corner.

Witnesses:  
S66W 16.00', N&T, 20" Oak (OBT)  
S15W 45.89', N&T, 30" Oak (OBT)  
N40E 28.70', N&T, 22" Oak (OBT)  
N58W 26.45', N&T, 12" Maple

Signed by Mark R. Robison  
Surveyor's Michigan License No. 27458

Date 10-31-97

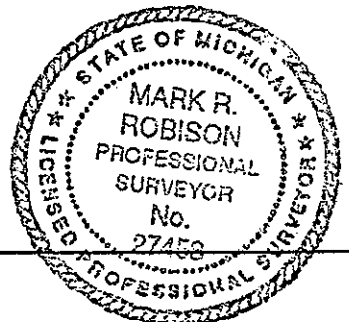

RECEIVED  
#228-97  
97 NOV -4 PM 3:15  
REGISTER OF DEEDS  
CLARE COUNTY  
CAROL A. McAULAY

Register of Deeds Stamp & File Number

	A	B	C	D	E	F	G	H	I	J	K	L	M
1													
2	6		5		4		3		2		1		
3													
4	7		8		9		10		11		12		
5													
6	18		17		16		15		14		13		
7													
8	19		20		21		22		23		24		
9													
10	30		29		28		27		26		25		
11													
12	31		32		33		34		35		36		
13													