

SURVEY & REMONUMENTATION COMMISSION
APR 06 1995

LAND CORNER RECORDATION CERTIFICATE 94
Filing Requirement of Act 74, Mich. P.A. 1970

RECEIVED
 E 10 A 0
 # 65-94
 NOV 28 AM 10:36
 REGISTER OF DEEDS
 CLARE COUNTY
 DONNA M. CARR

For corners in CLARE (County) Located In: _____ Corner Code D-7

1. Public Land Survey	T	<u>18N</u>	R	<u>5W</u>	_____
	T	_____	R	_____	_____
	T	_____	R	_____	_____
	T	_____	R	_____	_____
2. Property Controlling in Section	S	_____	T	_____	R
	S	_____	T	_____	R
3. Miscellaneous Property in Sec.	S	_____	T	_____	R
	S	_____	T	_____	R

4. Lot No. _____, Recorded Plat _____
 5. Private Claims _____

Register of Deeds Stamp & File Number

A	B	C	D	E	F	G	H	I	J	K	L	M
2	6	5	4	3	2	1						
3												
4	7	8	9	10	11	12						
5												
6	18	17	16	15	14	13						
7												
8	19	20	21	22	23	24						
9												
10	30	29	28	27	26	25						
11												
12	31	32	33	34	35	36						
13												

I, MARK R. ROBISON, in a field survey on OCTOBER, 19 94, do hereby certify that under requirements of P.A. 74, Michigan P.A. of 1970, the corner points mentioned in lines 1 and 2 above were in conformance with regulations and rules therefore as required in the current manual of survey instructions of the United States Department of the Interior, Bureau of Land Management or by a decree of a Court of Law and/or that the corner points mentioned in lines 3, 4 and 5 above were in conformance with the rules of the Michigan Board of Land Surveyors or by a Decree of a Court of Law, established, re-established, monumented, re-monumented, recovered, found as expressed below:

NOTE: Not more than 4 corners, all in the same town and range, may be recorded on this certificate.


- A. Description of original monument and accessories and/or subsequent restoration:
 SEPT. 1856, CANNON, POST, G.L.O.
 (1) HEMLOCK 12" S66°E 23
 (2) HEMLOCK 14" N53°W 16
 3-29-02 W.W. HARPER, C.S.R. 10-1
 (3) HEMLOCK 20" N51°W 49 LKS N.B.T.
 (4) HEMLOCK 14' N55°W 16 LKS GOV'T. WITNESS GOOD BUT DOWN
 10-23-72 VERBA, FOUND 5/8" IRON L.C.R.C. 74-72
 (5) CENTERLINE OF BLOWOFF AZ. 35° 84.30'
 (6) N&T, OAK 16" AZ. 72° 49.82'
 (7) N&T, OAK 8" AZ. 150° 8.65'
 (8) N&T, TWIN OAK 10" AZ. 325° 28.60'
 12-19-72 VERBA, F.I.P. SURVEY (132) 1-410

- B. Description of corner evidence found and/or method applied in restoring or reestablishing corner:
 FOUND 5/8"x18" SUCKER ROD. EXCAVATED TO DEPTH OF 3 FEET.
 FOUND NO FUTHER EVIDENCE.
 FOUND WITNESS #6 AND STUMP OF WITNESS #8.
 WITNESS #5 APPEARS TO HAVE BEEN RE-BUILT
 WITNESS #7 IS EITHER GONE OR WAS RECORDED IN ERROR.

APPROVED LAND CORNER
 P.A. 345 of 1990
 Clare County
 Chairman Paul S. Lepke
 Date Nov. 23, 1994

This Corner established in Clare County Remonumentation Program.
 See dossier for detailed report.

- C. Description of monument for corner and accessories established to perpetuate locating the position of the corner:
 SET 5/8"x36" RE-ROD WITH 3" CLARE COUNTY MONUMENT CAP IN MONUMENT BOX.
 WITNESSES: N72°E, 49.82'- NAIL & TAG IN 20" OAK (6)
 N10°E, 76.78'- CENTER OF NEW BLOWOFF VALVE
 S20°E, 28.05'- NAIL & TAG IN 12" OAK
 N40°W, 85.27'- NAIL & TAG IN POWER POLE

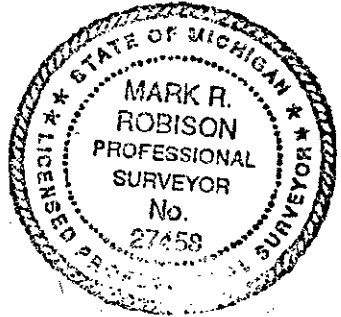

Signed by Mark R. Robison Date 11-23-94
 Surveyor's Michigan License No. 27458