

MAR 24 2000

SECTION

LAND CORNER RECORDATION CERTIFICATE
 Filing Requirement of Act 74, Mich. P.A. 1970
 Clare County Remonumentation

For Corners in
Clare
 (County)

1. Public Land Survey	T. <u>18N</u> R. <u>5W</u>	<u>F-7</u>
	T. _____ R. _____	_____
	T. _____ R. _____	_____
2. Public Controlling in Section	S. _____ T. _____ R. _____	_____
	S. _____ T. _____ R. _____	_____
3. Miscellaneous Property in Section	S. _____ T. _____ R. _____	_____
	S. _____ T. _____ R. _____	_____
4. Lot No. _____, Recorded Plat _____		
5. Private Claims _____		

199900010461
 Filed for Record in
 CLARE COUNTY MICHIGAN
 CAROL MCAULAY
 On 12-03-1999 At 02:35 pm.
 LAND CORNER 9.00
 OR Liber 2 Page 99 - 99

Instrument 199900010461 OR Liber Page 2 99

387-99

Register of Deeds Stamp & File Number

I, Mark R. Robison, in a field survey on October 6, 1999, do hereby certify that under requirements of P.A. 74, Michigan P.A. of 1970, the corner points mentioned in lines 1 and 2 above were in conformance with regulations and rules therefore as required in the current manual of survey instructions of the United States Department of the Interior, Bureau of Land Management or by a decree of a Court of Law and/or that the corner points mentioned in lines 3, 4 and 5 above were in conformance with the rules of the Michigan Board of Land Surveyors or by a Decree of a Court of Law established, re-established, monumented, re-monumented, recovered, found as expressed below.

1	A	B	C	D	E	F	G	H	I	J	K	L	M
2	6	5	4	3	2	1							
3													
4	7	8	9	10	11	12							
5													
6	18	17	16	15	14	13							
7													
8	19	20	21	22	23	24							
9													
10	30	29	28	27	26	25							
11													
12	31	32	33	34	35	36							
13													

NOTE: Not more than 2 corners, all in the same town and range, may be recorded on this certificate.

A. Description of original monument and accessories and/or subsequent restoration:

- 1856 Cannon
 1/4 Sec Post
 Y. Pine 22 S57E 67
 W. Pine 12 N55W 43
 1972 Lapham, L.13 Pg. 33
 Stiner Subd. No. 2
 P.O.B. is S1/4 Cor
- 1927 Johnson, L12, Pg. 34-35
 Map of Oakdale Resort on Lake George
 1987 Lapham LCRC #556
 Fd 3" Pipe
 N45W 46.9 12" Maple
 S40W 54.2 P.P.
 S89W 30.0 6" Poplar
 1991 & 1992 Robison, (132) 620-210 &
 Unrecorded Survey
 Same witnesses as LCRC #556
- 1960 Lapham, L6, Pg. 1
 Wigwah Trails
 (Note: This apparently recorded in error since corner material and witnesses were not found and the 6" Poplar would fall in a long established road).
- 1981 Wilcox LCRC #411
 Fd concrete monument per Plat of Oakdale Resort
 North 17.30 Center Fence Post
 N75W 63.70 10" Soft Maple
 S65W 70.47 Pow. Pole
 S20W 44.95 2" Red Pine

APPROVED LAND CORNER
 P.A. 345 of 1990
 Clare County
 Chairman *Paul D. Lapham*
 Date 12-01-99

B. Description of corner evidence found and/or method applied in restoring or re-establishing corner:


See dossier for detailed report.
 Found old concrete Mon at corner. Fd all four 1981 witnesses and C.I. at 8-9 lot corner, WIGWAH TRAILS, 33' S. S.W. of conc Mon. LCRC #556 is recorded in error. Concrete Monument is 20" below road grade. Set Mon. Box and raised Mon. with 1/2" x 12" re-rod with Std. Remon Cap.

C. Description of monument for corner and accessories established to perpetuate locating the position of the corner:

Set 1/2" x 12" rered with Clare Co. Remon Cap marked P.S. #27458 over concrete Monument in Mon. Box in gravel road. Accepted as best available evidence of the accepted position of the corner.
 Witnesses:
 S31°E 57.55 Set N & T in 10" W. Pine
 S20°W 44.95 Set N & T in 6" R. Pine (OBT)
 S70°W 70.47 Set N & T in P.P. (OBT)
 N75°W 63.70 Set N & T in South Trunk of Maple Clump (OBT)
 SSW 33.0 C.I. at 8-9 Lot Cor. WIGWAH TRAIL.

Signed by Mark R. Robison
 Surveyor's Michigan License No. 27458

Date 12-1-99

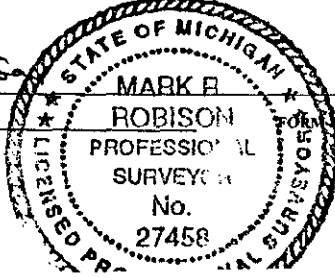

APPROVED BY MICHIGAN STATE BOARD OF LAND SURVEYORS, JAN. 28, 1971